


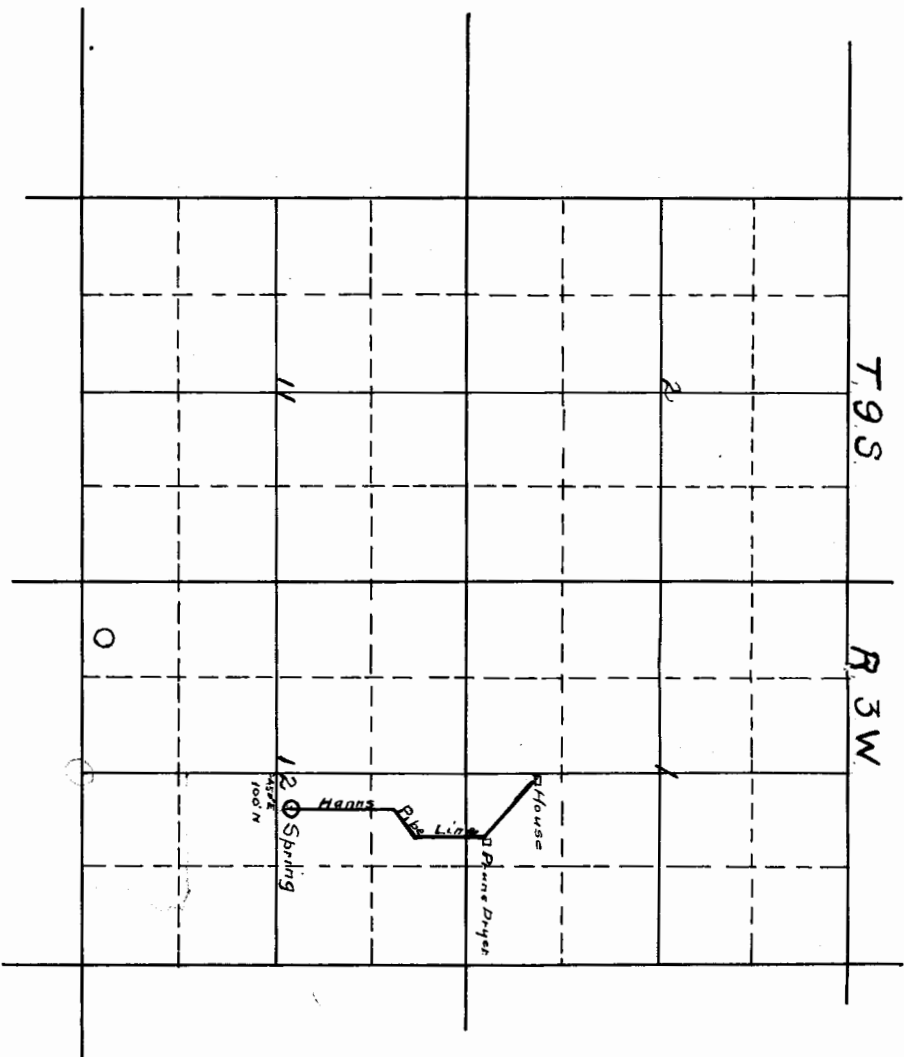

Map to accompany application of
R.W. Hann Turner Or

OFFICE OF STATE ENGINEER
RECEIVED
JUN 30 1913
SALMON CREEK

Application No. 3021
Permit No. 1600