


**T.6N.R.35E.W.M.**

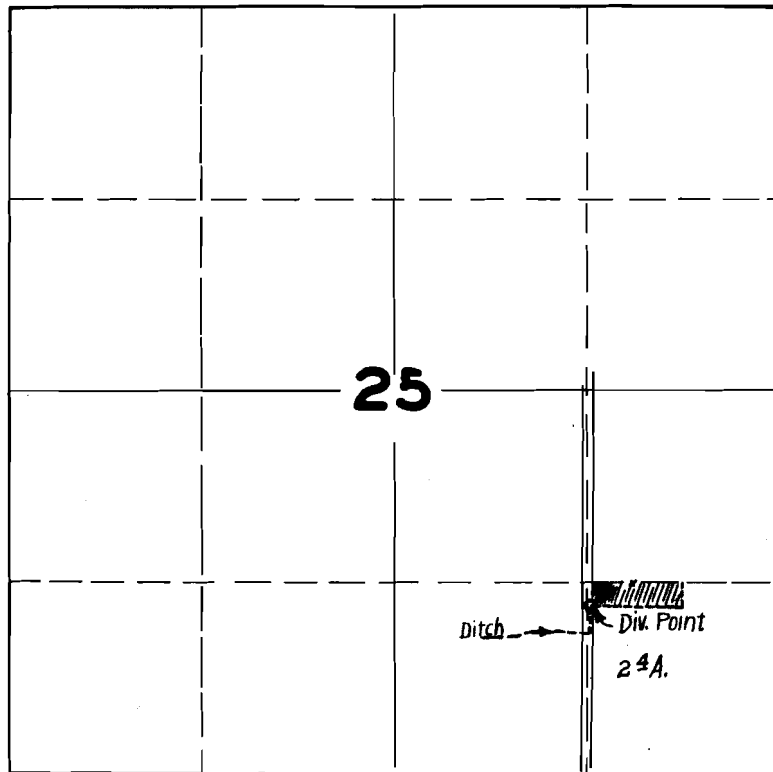

**FINAL PROOF SURVEY**  
UNDER

Application No. 24191... Permit No. 19021...  
IN NAME OF

..... FLOYD GOSSELIN .....

Surveyed OCT. 12, 1950, by H.L. COFFMAN..