


T.3N. R.10E. W.M.

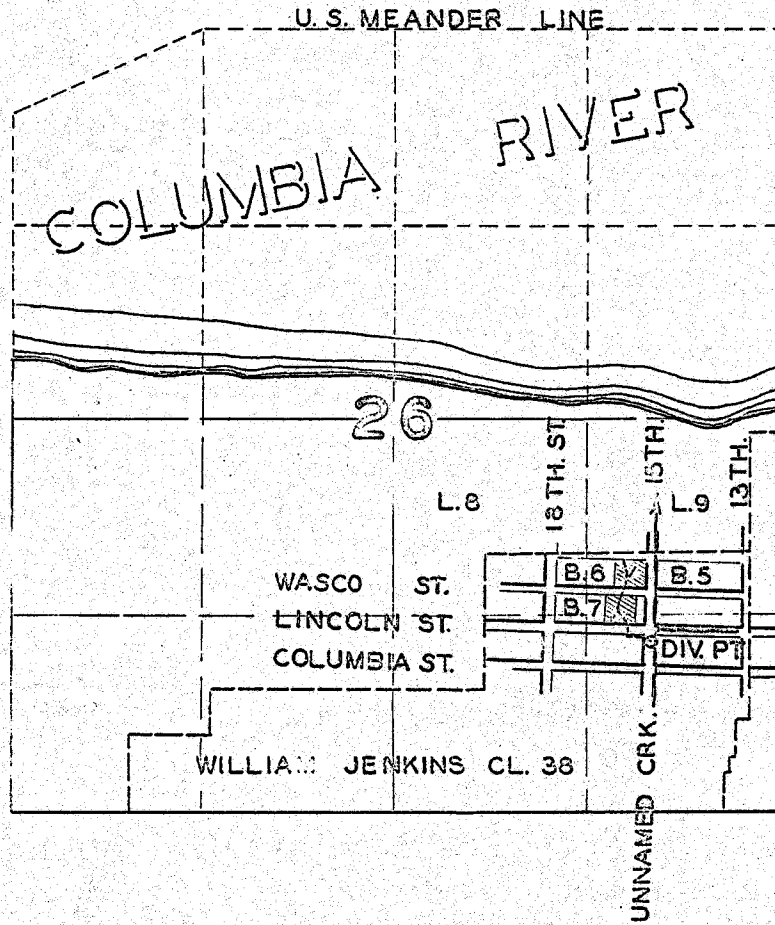

FINAL PROOF SURVEY UNDER

Application No. 20149. Permit No. 15731.
IN NAME OF

.....GEO. W. SPARKS.....

Surveyed JUNE 20 1950., by H.L. COFFMAN