


T 38 S., R 8 W., W. M

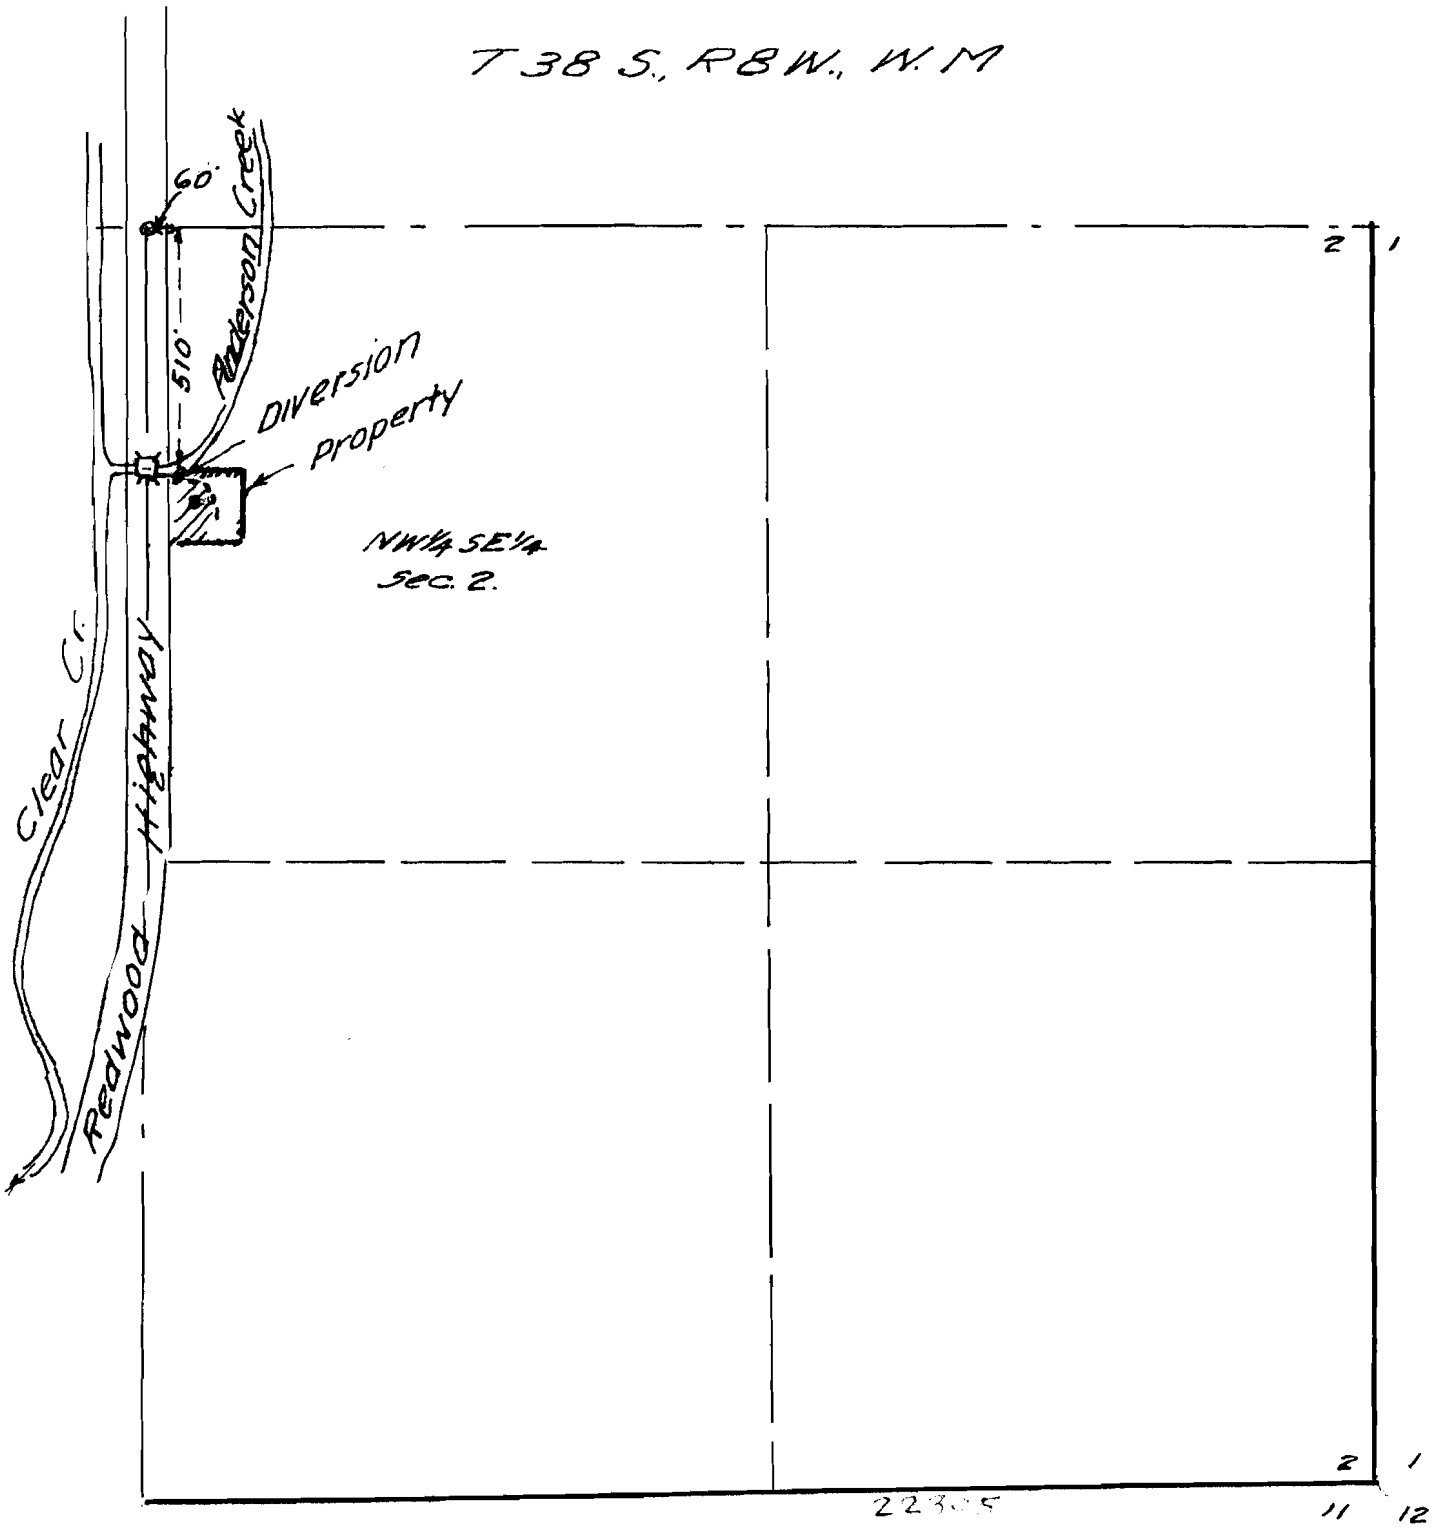

E. L. CROUSE
MARCH 1947

Application No. 22305
Permit No. 17589