


T.6N.R.35E.W.M.

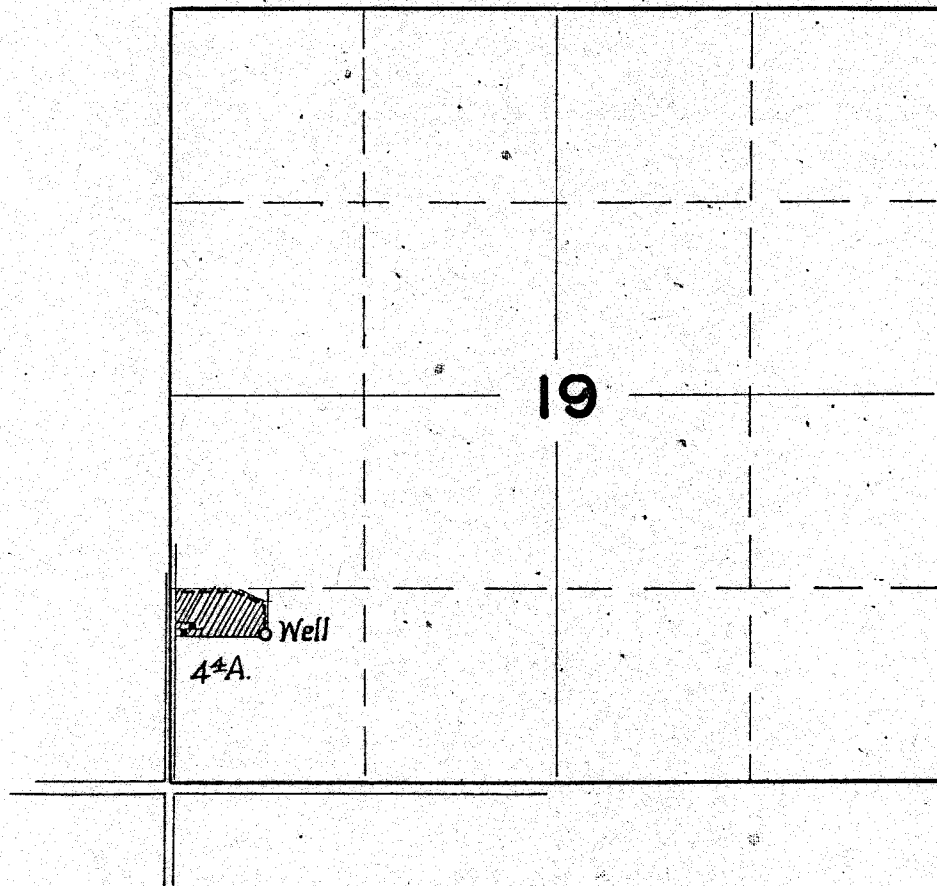

FINAL PROOF SURVEY

UNDER

Application No. U_197... Permit No. U_179...

IN NAME OF

V. J. & MRS. R. D. SWANSON

Surveyed OCT. 10. 1950., by H.L. COFFMAN.