


U-196
C-19634

T.6N.R.35E.W.M.

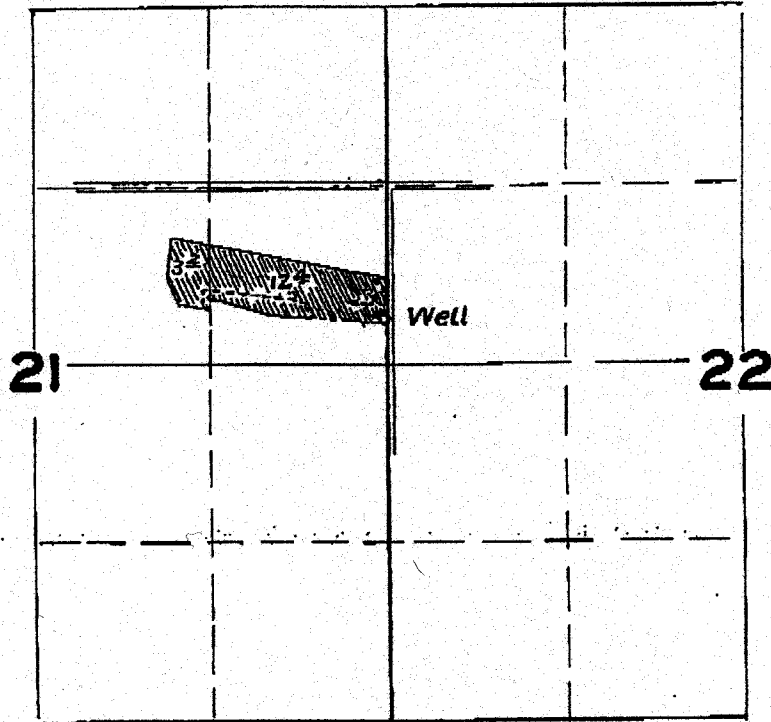

FINAL PROOF SURVEY UNDER

Application No. U_217. Permit No. U_196
IN NAME OF

.....OTTO BEHNKE.....

Surveyed OCT. 10, 1950, by H.L. COFFMAN