


T. 6N.R.35E.W.M.

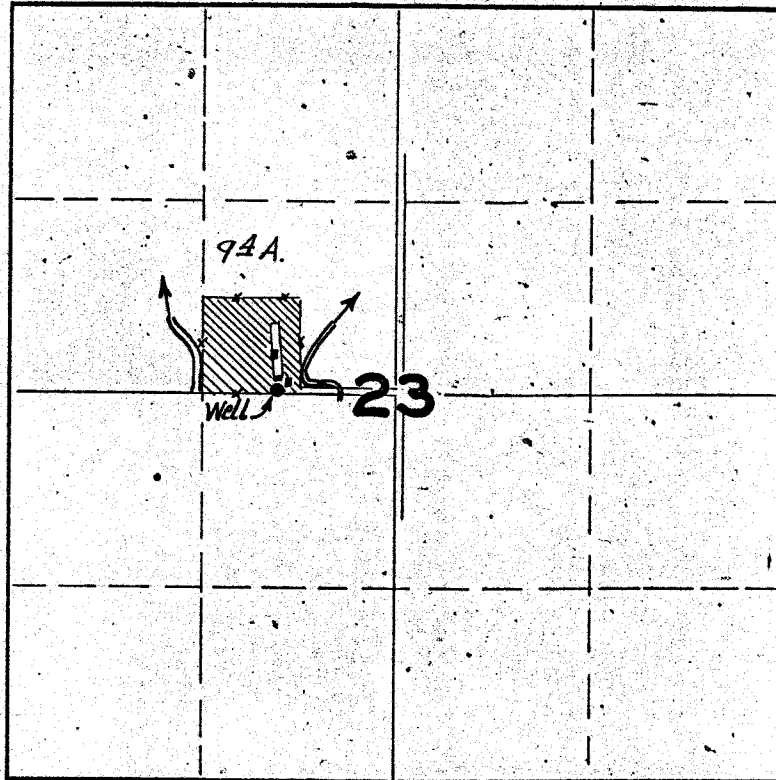

FINAL PROOF SURVEY

UNDER

Application No. U_253_ Permit No. U_225

IN NAME OF

MARVIN J. GILMORE

Surveyed OCT. 12. 1950, by H.L. COFFMAN