


T.10&11S. R.5W.W.M.

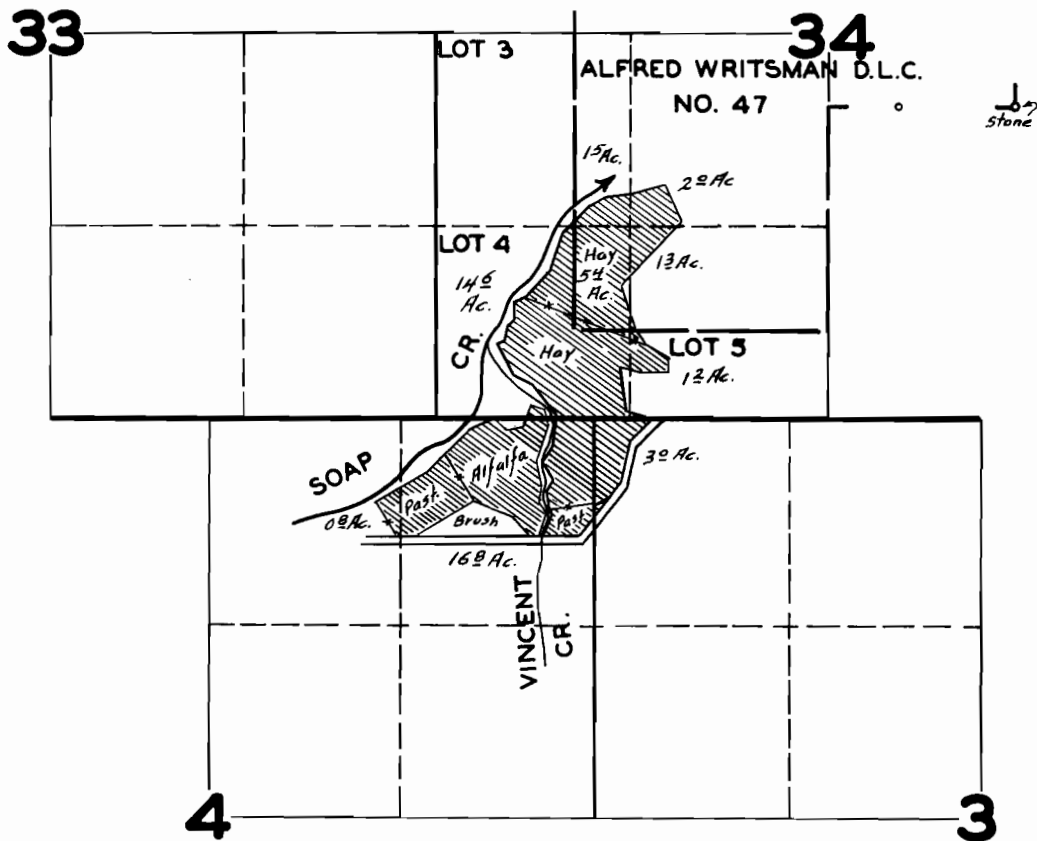

**FINAL PROOF SURVEY**  
UNDER

Application No. 17680 Permit No. 13371

IN NAME OF

GUSTAVE O. SELANDER

Surveyed JUNE 23 1947, by JAS. E. BUNNELL