


T. 6N. R. 35E. W. M.

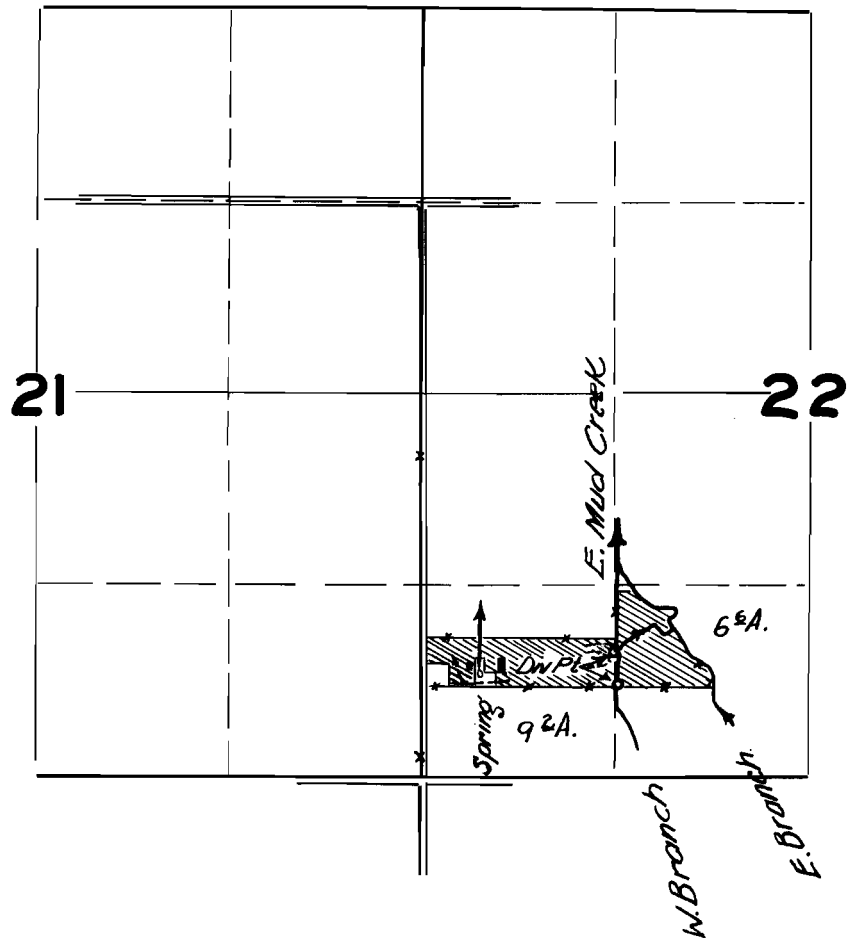

FINAL PROOF SURVEY

UNDER

Application No. 19814 ... Permit No. 15393

IN NAME OF

FRED G. BADE

Surveyed OCT. 8, 1950, by H.L. COFFMAN