


T.7N.R.5W.W.M.

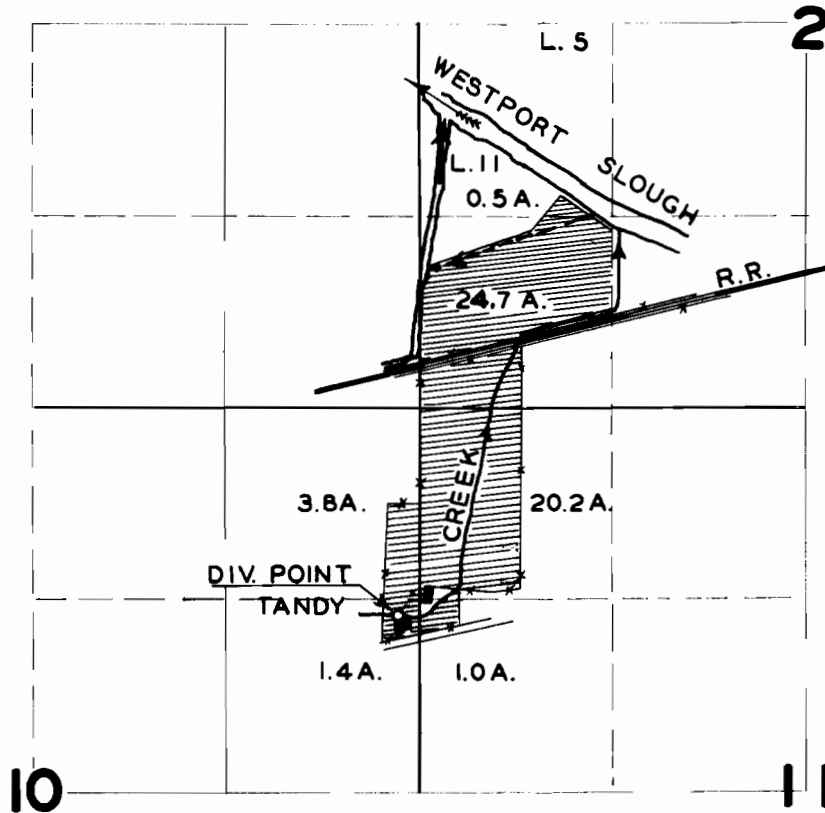

FINAL PROOF SURVEY

UNDER

Application No. 19846. Permit No. 15427.
IN NAME OF

TRACY S. & MERTA J. LYONS.

Surveyed AUG. 2, 1950, by H. L. COFFMAN