


T37SR8W, W.M.

Scale 400' = 1"

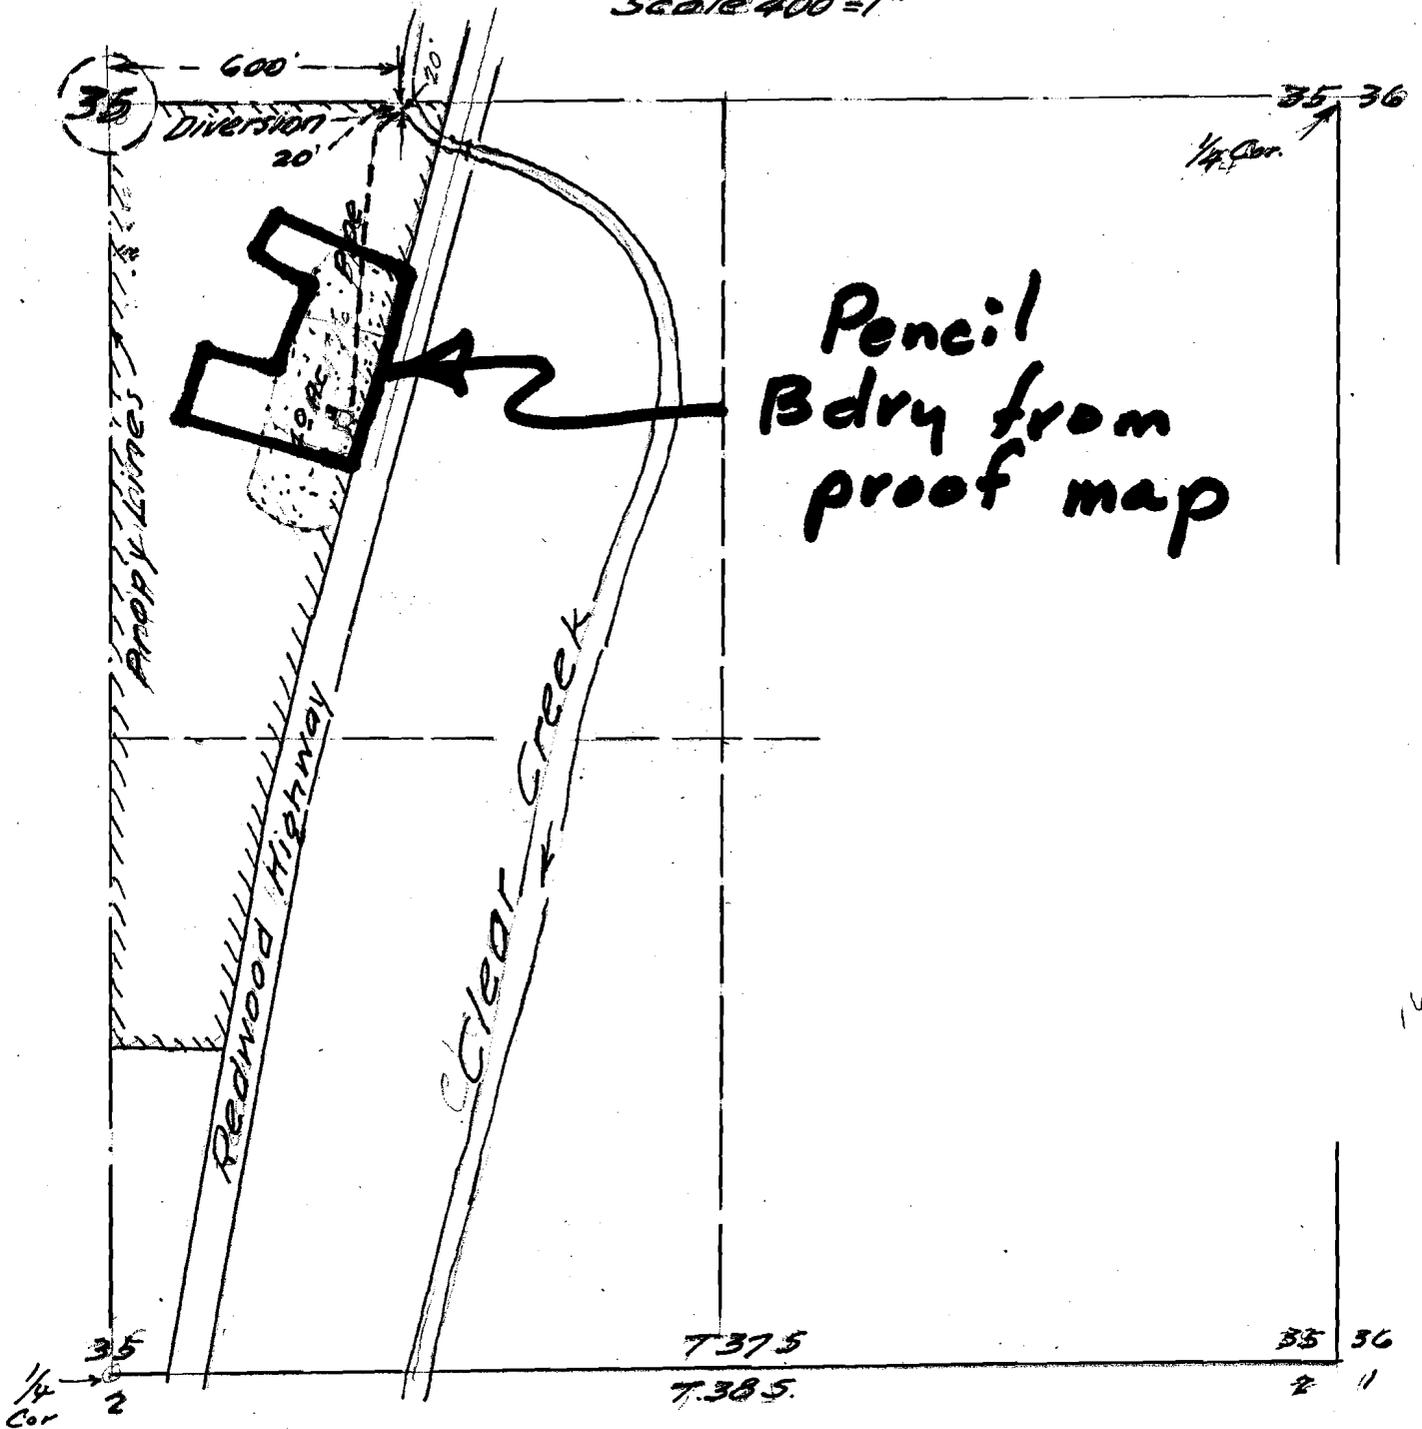

1603
15-56C

W. S. Stire
May 1946

Application No. 21603 21603
Permit No. 16972

RECEIVED
MAY 2 1946
STATE ENGINEER
SALEM, OREGON