


T.7N. R. 4W.W.M.

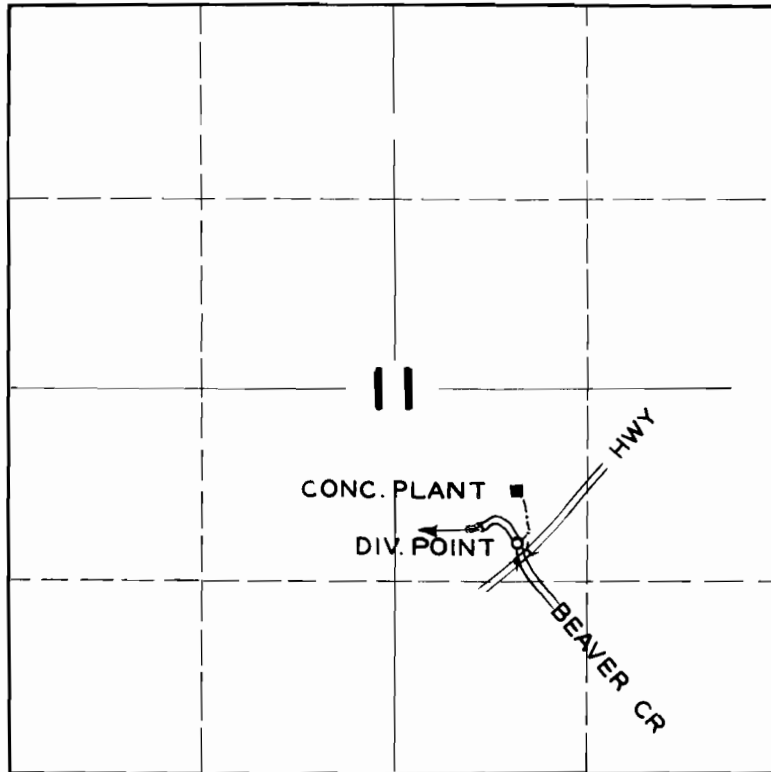

FINAL PROOF SURVEY UNDER

Application No 23486 Permit No. 18521
IN NAME OF

ADAMS CONCRETE & ROCK PLANT

Surveyed JULY 31, 1950, by H.L. COFFMAN