


T. 2N.R. 8E.W.M.

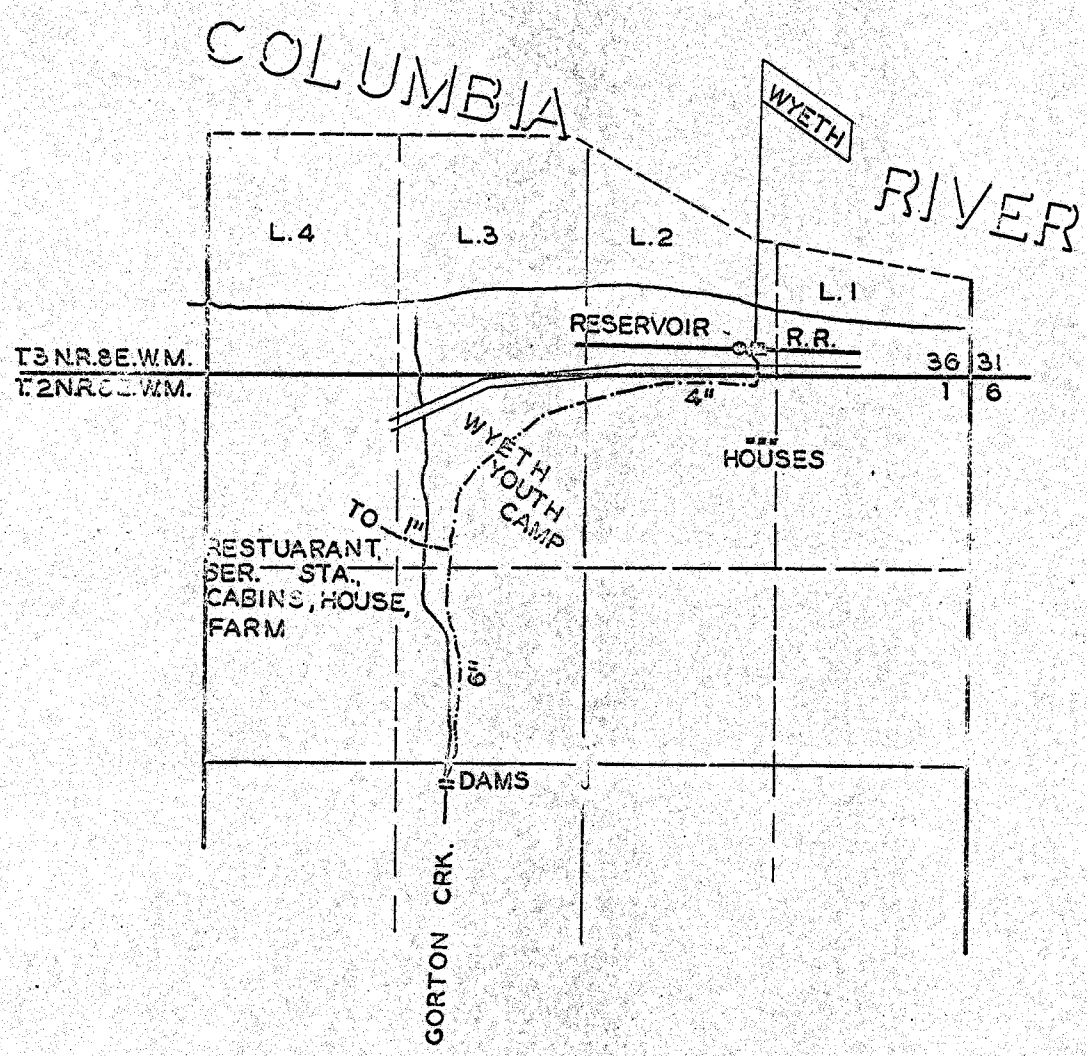

FINAL PROOF SURVEY UNDER

Application No. 21244 Permit No. 16650
IN NAME OF

O. W. R. R. & N. CO. & U. P. R. R. CO.

Surveyed JUNE 30 1950, by H. L. COFFMAN