


T.30S.R.5W.W.M.

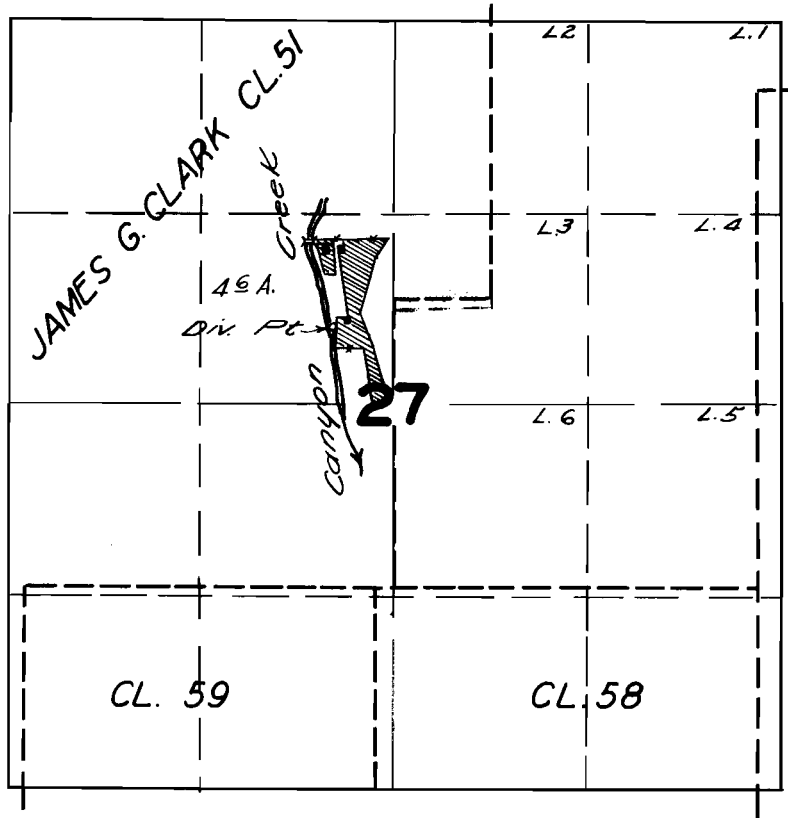

FINAL PROOF SURVEY

UNDER

Application No. **22168** Permit No. **17456**

IN NAME OF

JOHN HAMLIN

Surveyed **MAY 23 1950**, by **H.L. COFFMAN**