T. 9 S. R. 40 E. W. M.

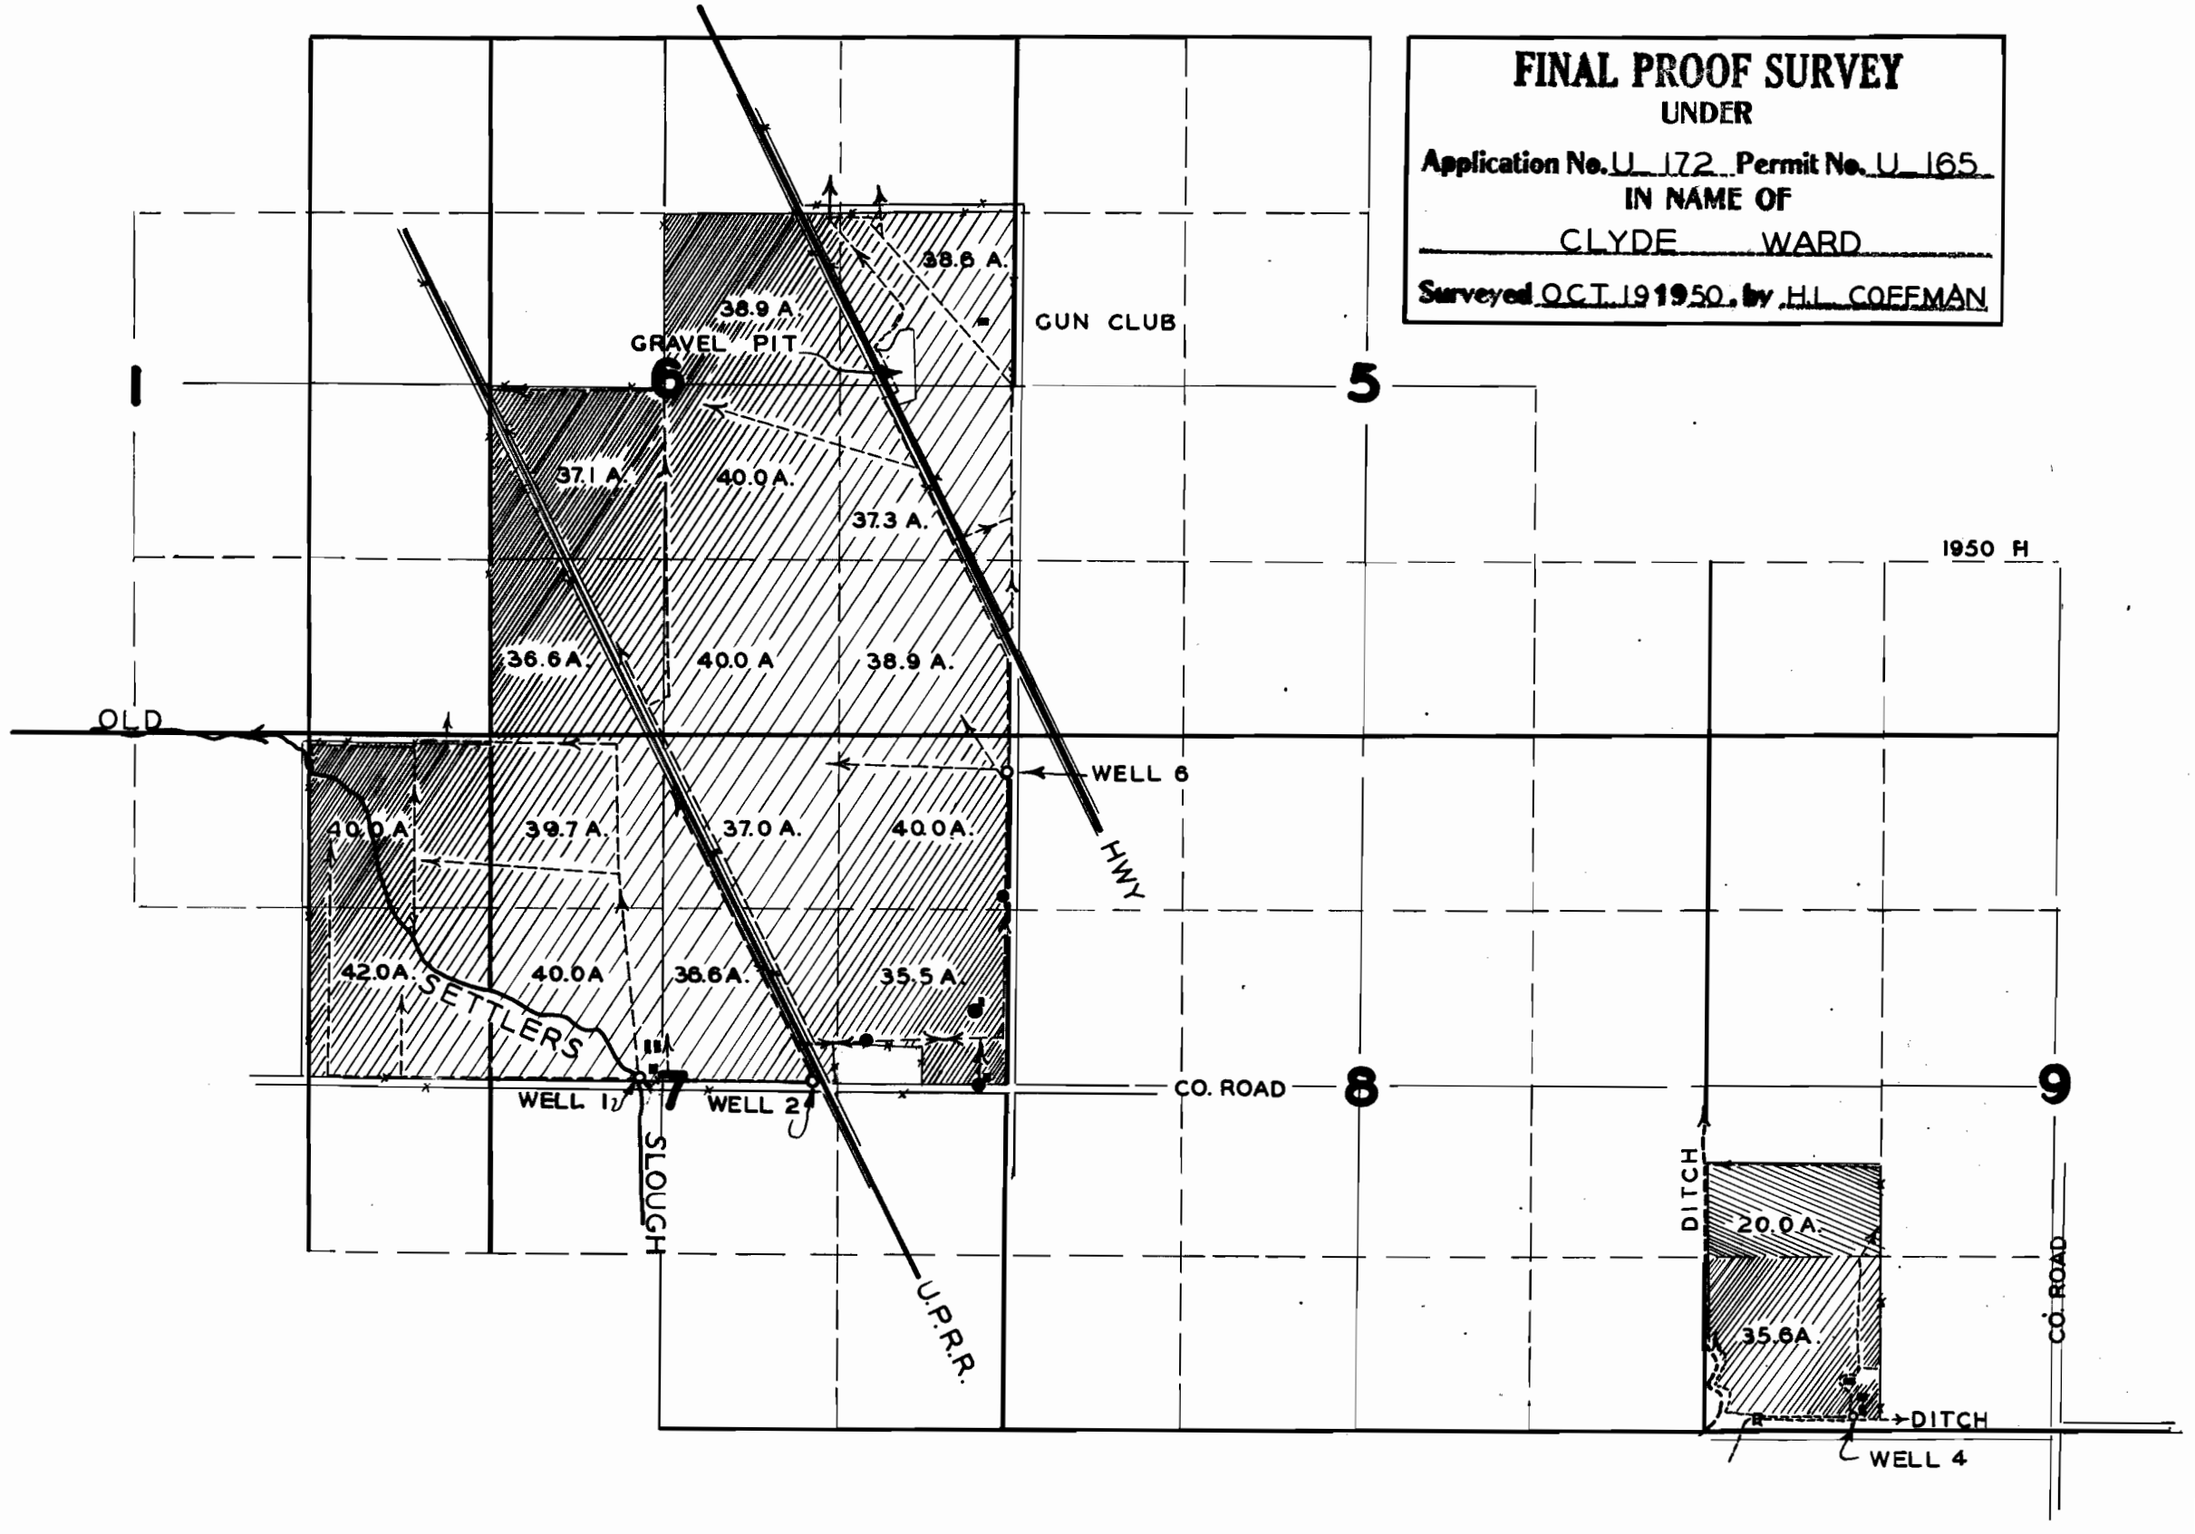
FINAL PROOF SURVEY
UNDER
Application No. U 172 Permit No. U 165
IN NAME OF
CLYDE WARD
Surveyed OCT. 1950, by H.L. COFFMAN
1
6
5
GUN CLUB
GRAVEL PIT
38.6 A.
38.9 A.
37.1 A.
40.0 A.
37.3 A.
1950 H
36.6 A.
40.0 A.
38.9 A.
OLD
WELL 6
HWY
40.0 A.
39.7 A.
37.0 A.
40.0 A.
42.0 A.
SETTLERS
40.0 A.
36.6 A.
35.5 A.
CO. ROAD
8
9
WELL 1
7
WELL 2
SLOUGH
U.P.R.R.
DITCH
20.0 A.
35.6 A.
CO. ROAD
DITCH
WELL 4