


U-197  
C-19654

# T.6N.R.35E.W.M

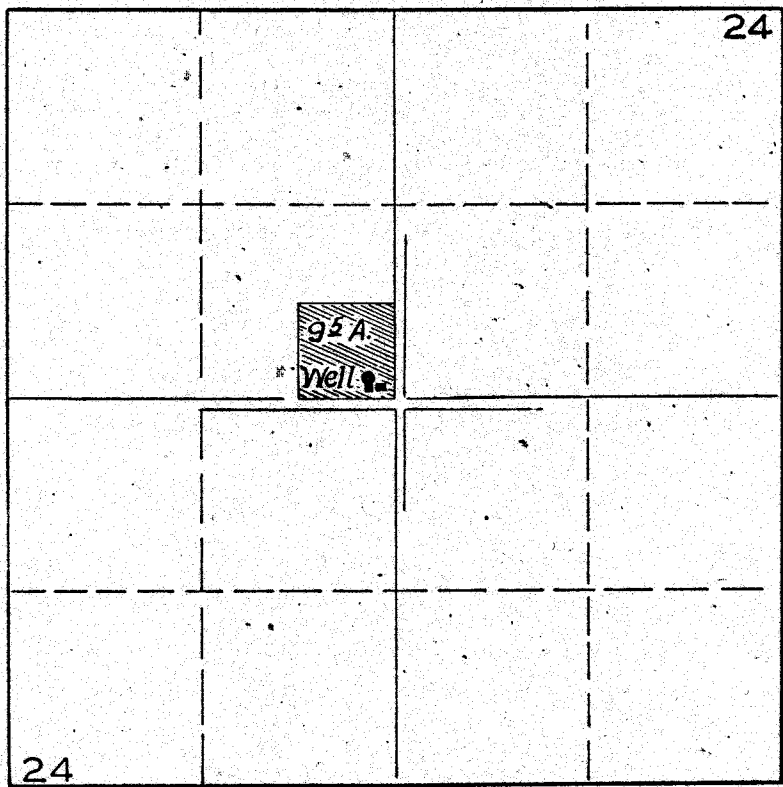

## FINAL PROOF SURVEY UNDER

Application No. U\_218\_ Permit No. U\_197\_  
IN NAME OF

.....ANDREW H. ZESSIN.....

Surveyed OCT. 12 1950., by H.L. COFFMAN