


T.38S. R.1 1/2 E.W.M.

Bucke G. & Yonna Valley Weeds

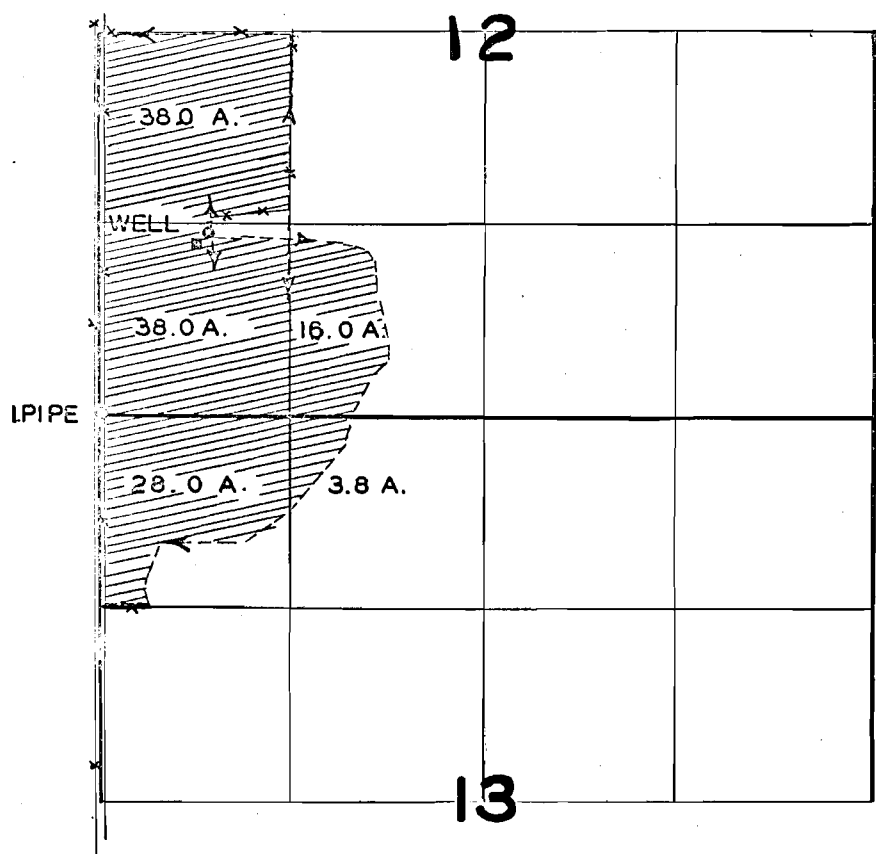

FINAL PROOF SURVEY UNDER

Application No. U-272. Permit No. U-244.
IN NAME OF

..... F. M. CHALLIS

Surveyed MAY 18, 1951, by H.L. COFFEMAN