


T.4N.R.1W.W.M.

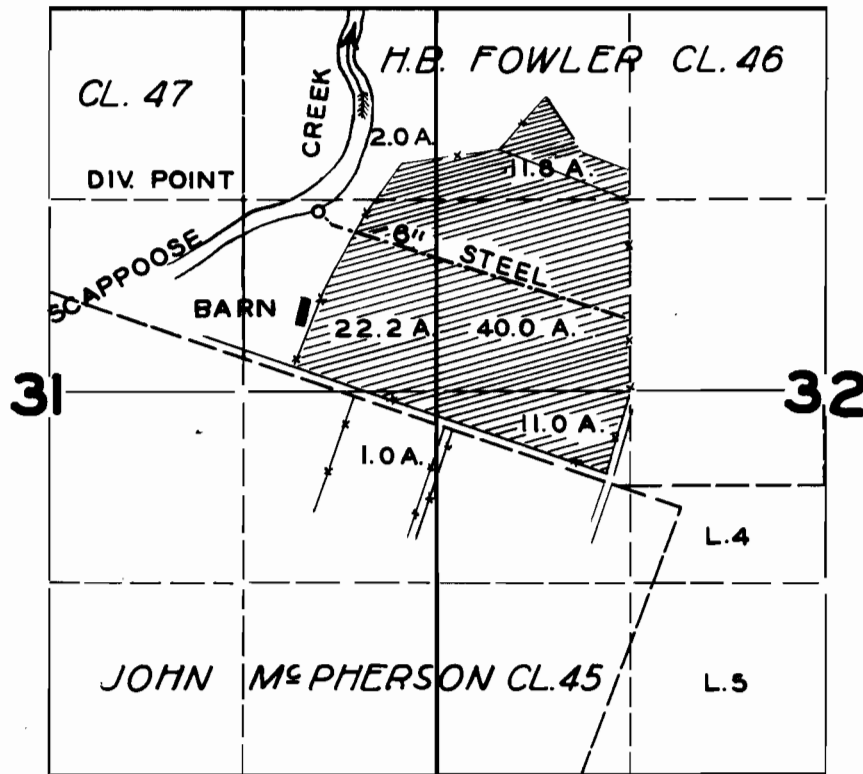

FINAL PROOF SURVEY

UNDER

Application No. 16797... Permit No. 12569

IN NAME OF

MRS. ANNIE KNUESEL

Surveyed AUG. 9 1950, by H.L. COFFMAN