T. 7 S. R. 4 W. W. M.

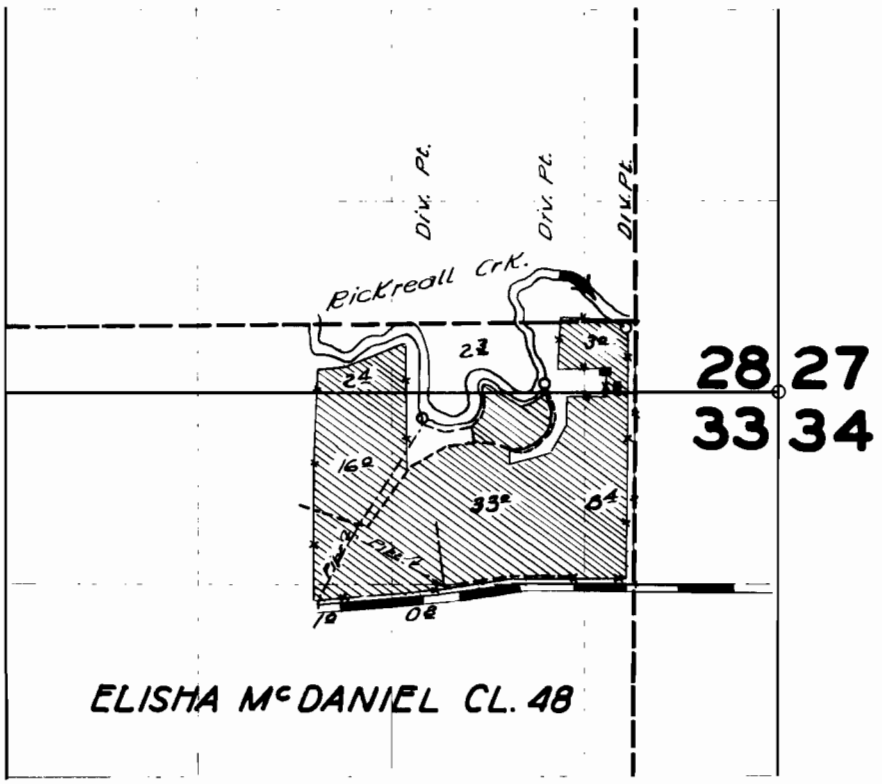

FINAL PROOF SURVEY

UNDER

Application No. 17137 Permit No. 12137 — 12560

IN NAME OF

DERREL D. HEWITT

Surveyed APR. 7 1950, by H.L. COFFMAN

1950 A