


North

RECEIVED

JUL 7 - 1938

STATE ENGINEER  
SALEM, OREGON

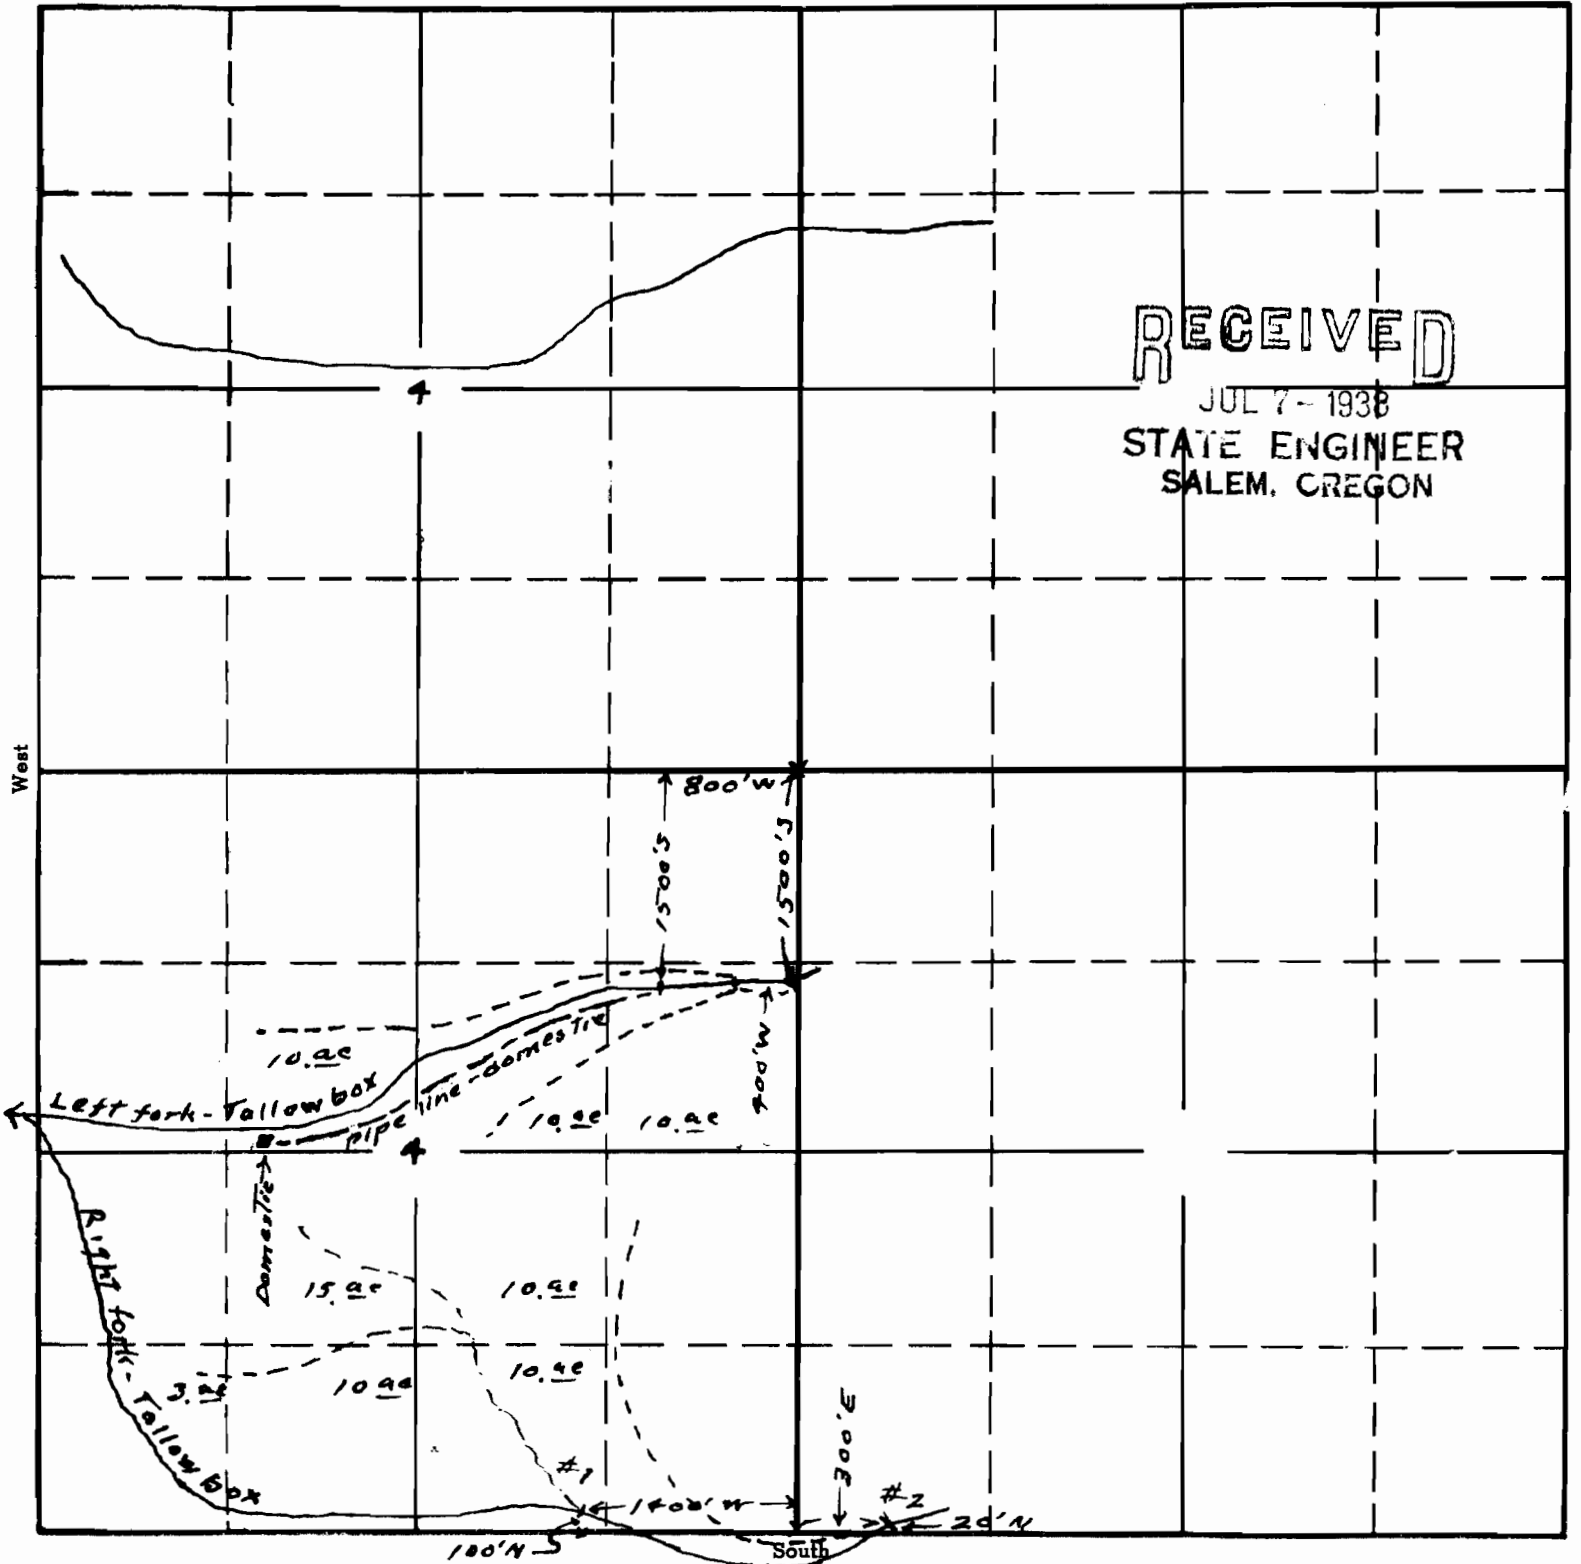

Corrected map showing points of divisions  
 and place of use accompanying application of  
 J.R. Hoffman for use of waters of R. and L. Forks of  
 Yellowbox Creek for irrigation and domestic.

17309  
 APPLICATION No. 17309  
 PERMIT No. 13007

- Red ink used, corrected change -

This office July 3, 1938 E.H. Smith