


# T.20S. R.5W.W.M.

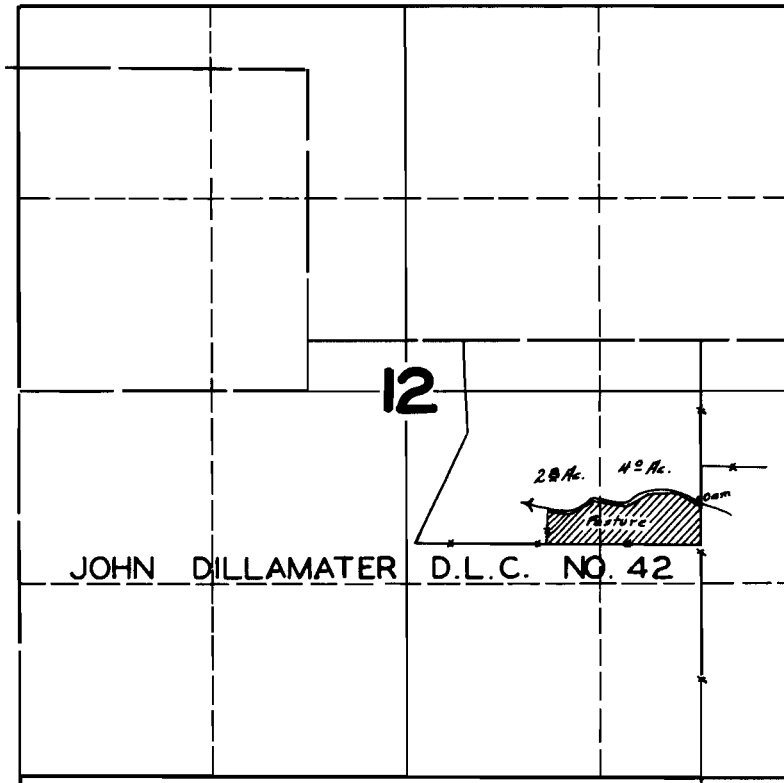

## FINAL PROOF SURVEY UNDER

Application No. 17902 Permit No. 13589

IN NAME OF

NANCY C. STEPHENS

Surveyed JULY 9, 1945, by *[Signature]*