


# T.29S.R.3W.WM

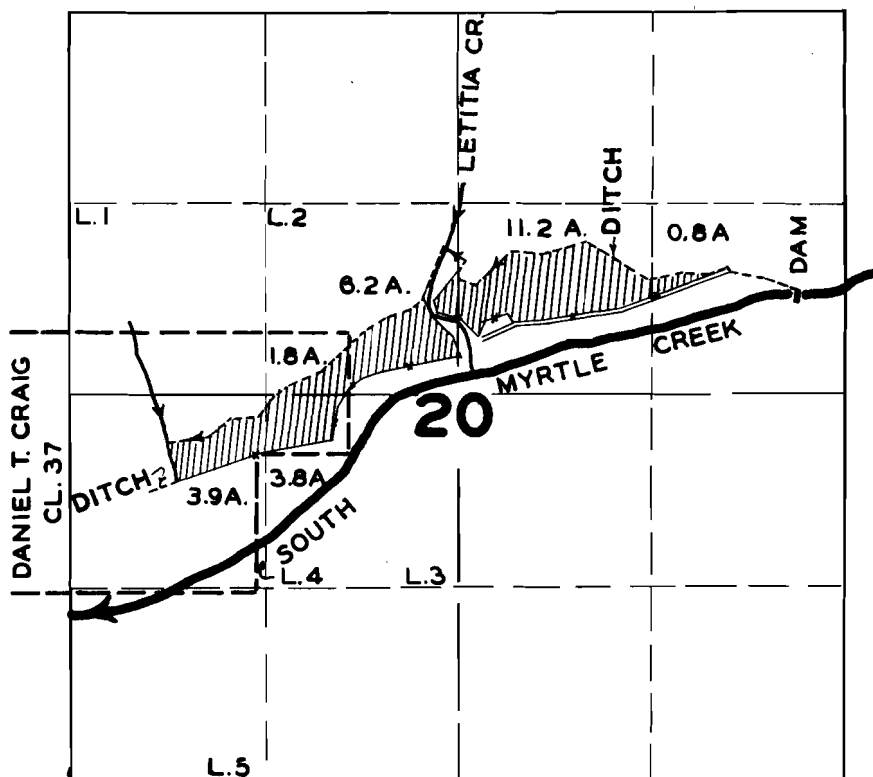

## FINAL PROOF SURVEY

UNDER

Application No. 19284... Permit No. 14876...

IN NAME OF

T. S. McALARY & E. W. HOLLINGER  
RUSS. A. BRIGGS, J. R. HALL

Surveyed MAY. 21. 1950., by H.L. COFFMAN..