


T.3N. R.10E.W.M.

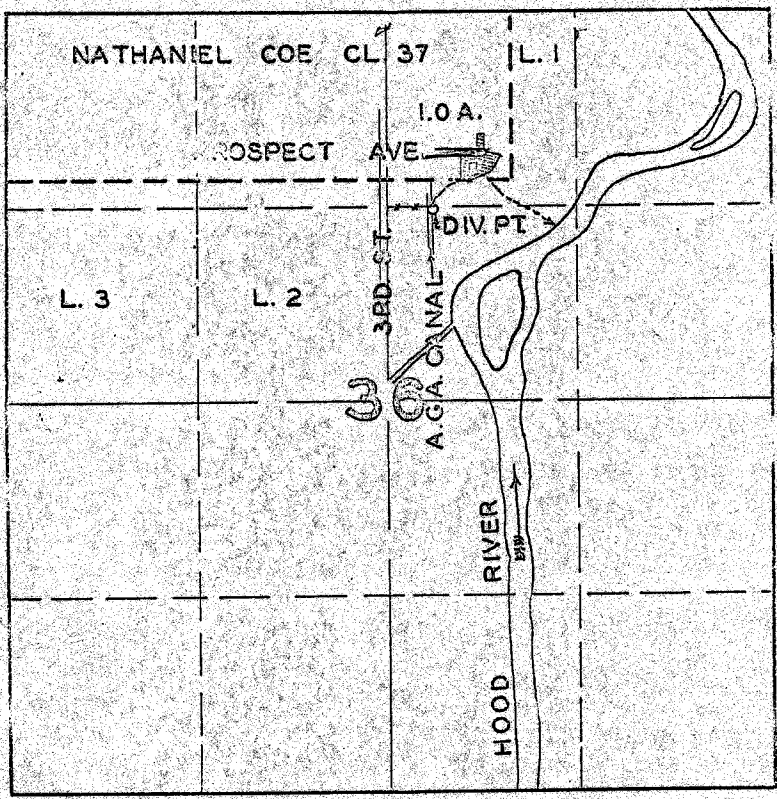

FINAL PROOF SURVEY UNDER

Application No. 19223. Permit No. 14649
IN NAME OF

RODERICK & MAUDE McRAE

Surveyed JUNE 14 1950, by H.L. COFFMAN