


T. 1 S. R. 9 W. W. M.

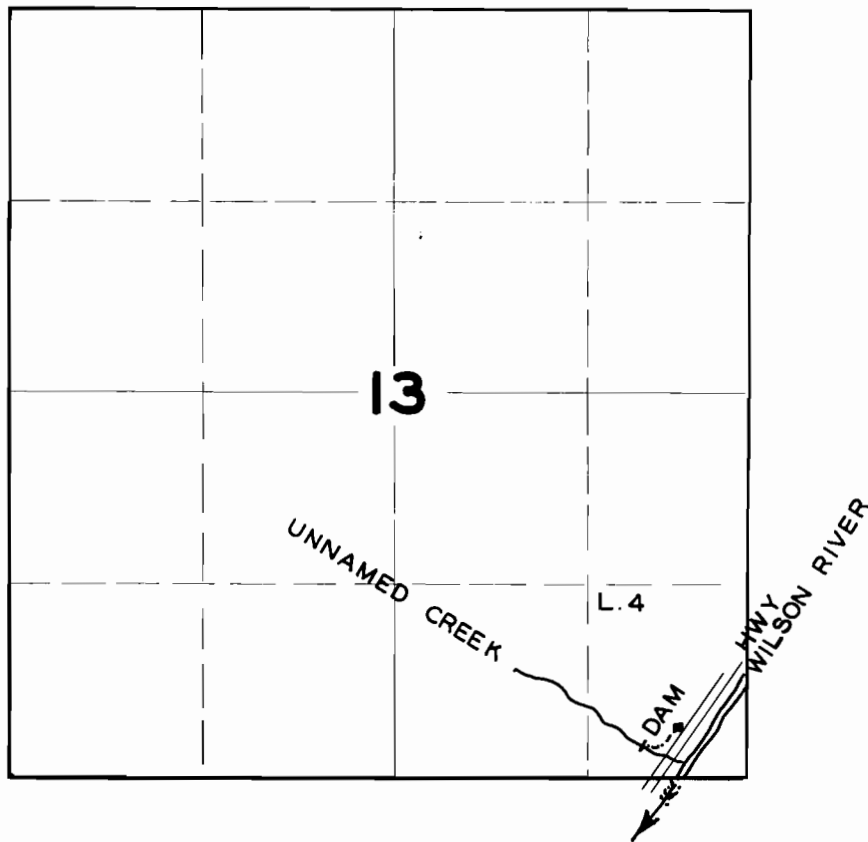

**FINAL PROOF SURVEY**

UNDER

Application No. 19669 ... Permit No. 15250...

IN NAME OF

..... BURCKARD .. ET AL. ....

Surveyed AUG. 15 1950, by H. L. COFFMAN