


T. 2 S. R. 2 E. W. M.

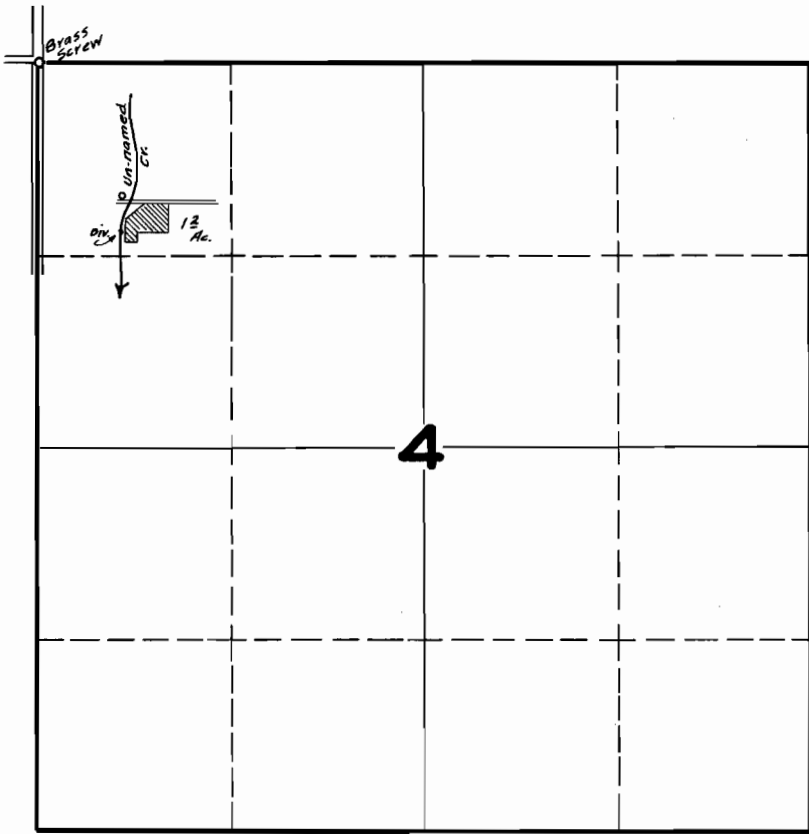

FINAL PROOF SURVEY
UNDER

Application No. 19853 Permit No. 15432

IN NAME OF
S. H. GUILD

Surveyed JUN. 11, 1947, by JAS. E. BUNNELL