


# T. IS. R. 9 W.W.M.

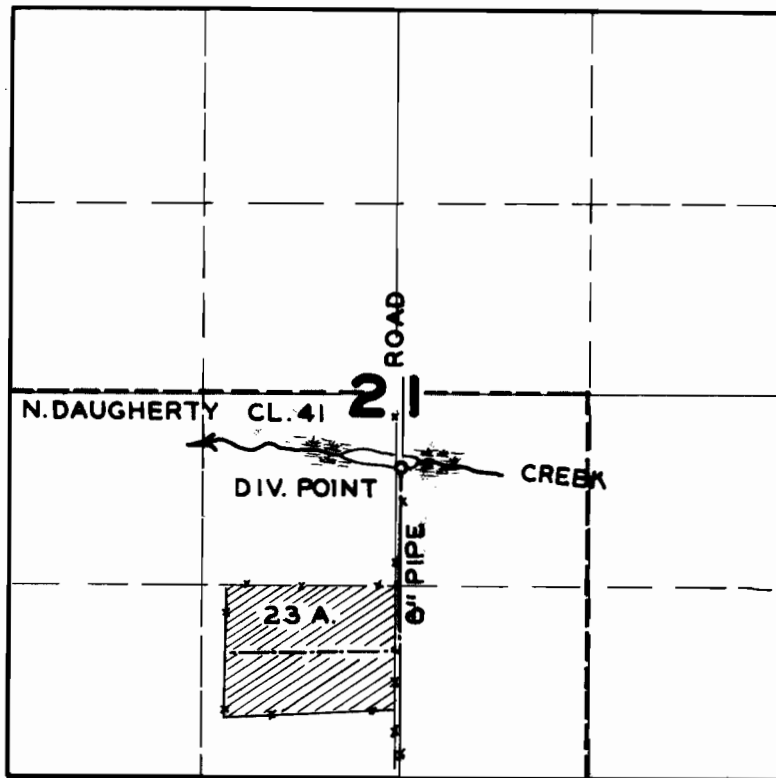

## FINAL PROOF SURVEY

UNDER

Application No. 2042.1. Permit No. 16056  
IN NAME OF

L. G. ROBINSON

Surveyed AUG. 15, 1950, by H. L. COFFMAN