


T.4N.R.36E.W.M.

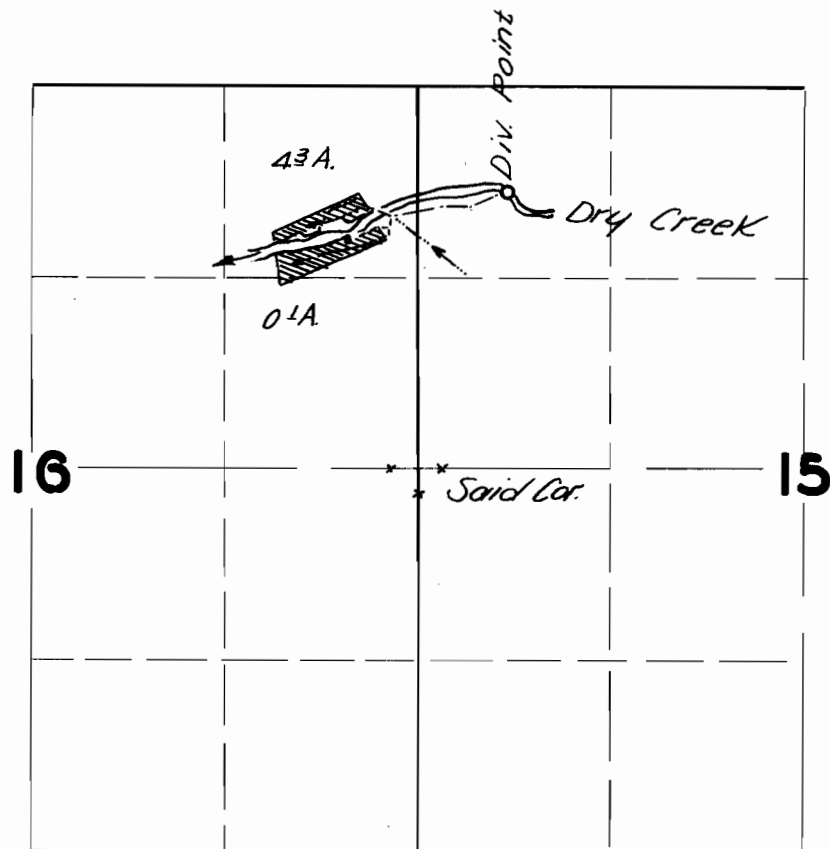

FINAL PROOF SURVEY

UNDER

Application No. 20534. Permit No. 16110.....
IN NAME OF

JAMES S. SCOTT

Surveyed OCT. 3, 1950, by H.L. COFFMAN