


T.29 S. R.5W.W.M.

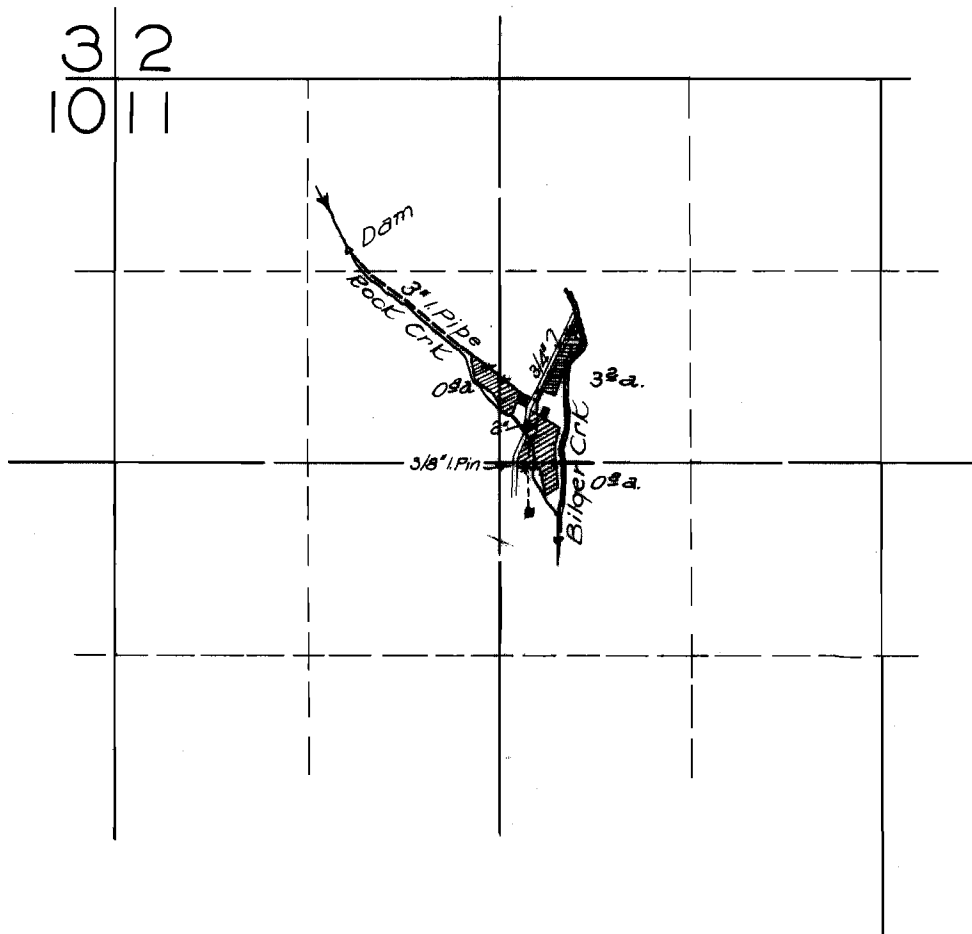

FINAL PROOF SURVEY

UNDER

Application No. 20777 Permit No. 16259...

IN NAME OF

TROY A. WALLACE & VIOLET M. WALLACE

Surveyed JUL 23 1949, by *H.L. COFFMAN*