


T.11S.R.7W.W.M.

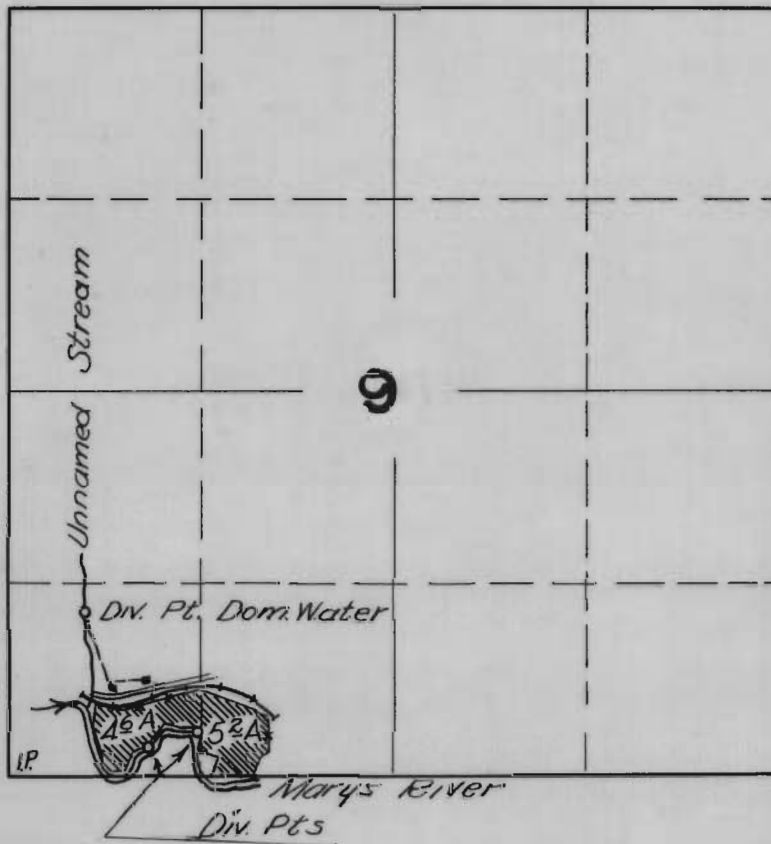

FINAL PROOF SURVEY

UNDER

Application No. 20825 Permit No. 16296...

IN NAME OF

W. V. CLARK

Surveyed SEP. 26. 1950, by H.L. COFFMAN