


# T.30SR.5W.W.M.

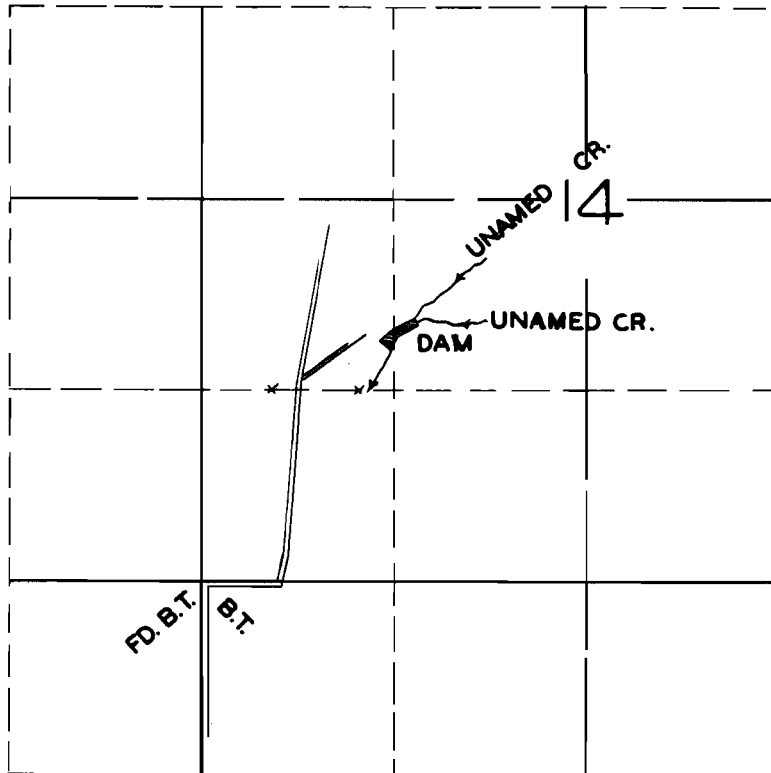

## FINAL PROOF SURVEY

UNDER

21158

16579

Application No. R. 21157 Permit No. R. 827

IN NAME OF

ELMER F. PEARSON

Surveyed JUL. 28 1949, by H.L. COFFMAN