


T.7N.R.9W.W.M.

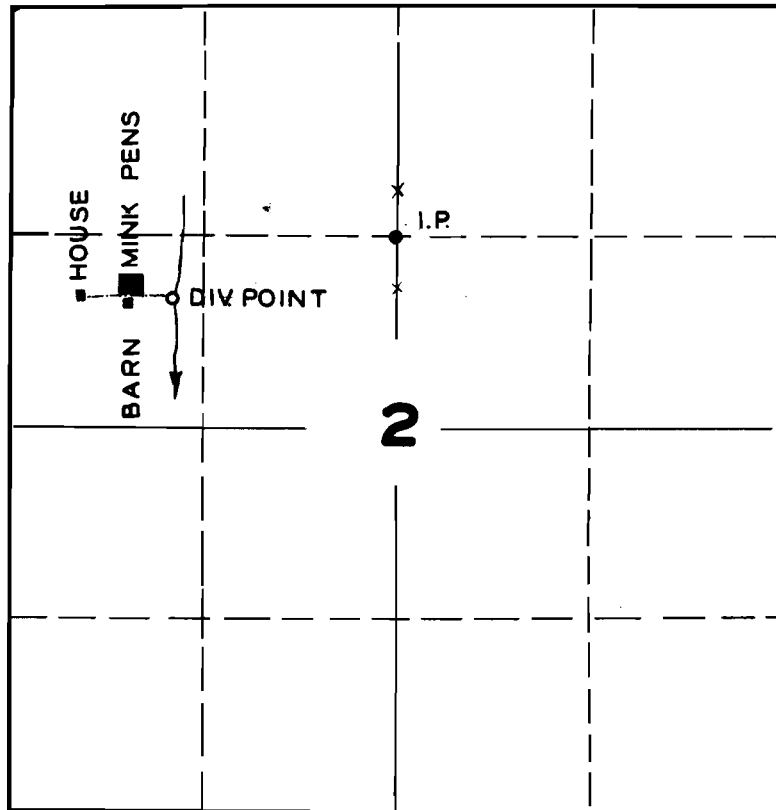

FINAL PROOF SURVEY

UNDER

Application No. 22252 Permit No. 17550

IN NAME OF

.....GEORGE F. IRVING.....

Surveyed JULY 27 1950, by H.L. COFFMAN