


T. 36 S., R. 3 W., W.M.

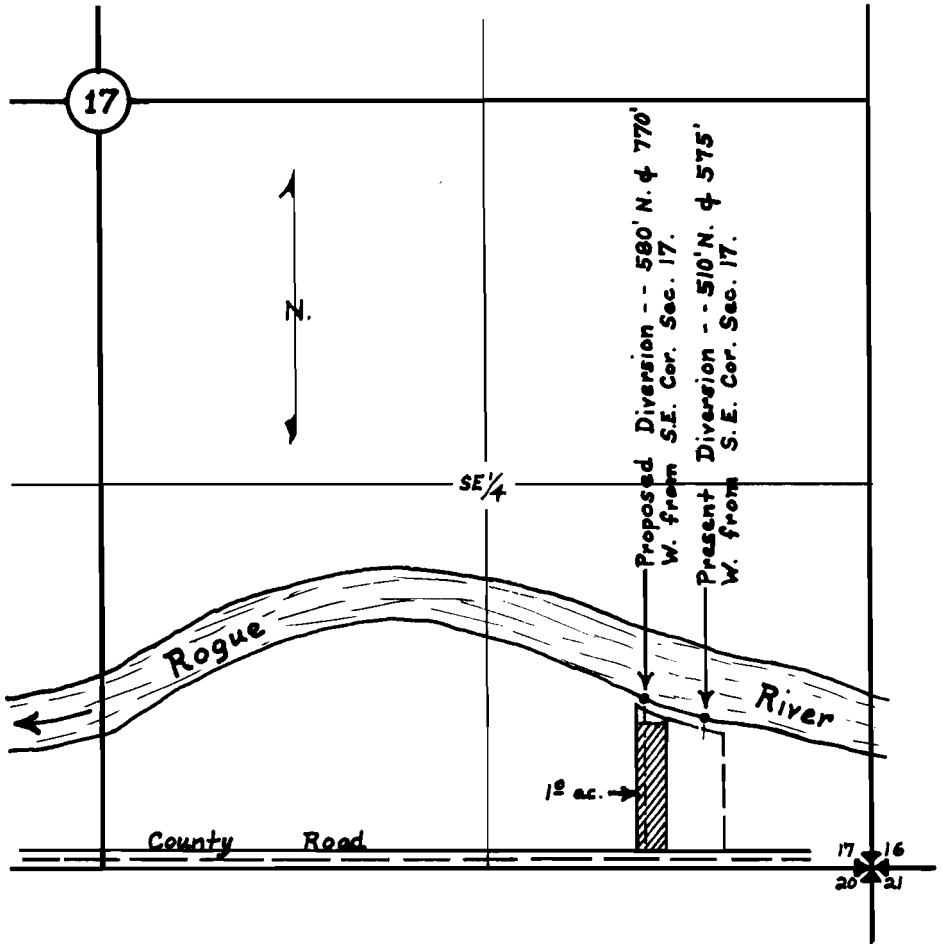

Map to accompany application of Thomas W. Harris, for a change in point of diversion.

Jan. 26, 1960 Scale: 8" = 1 mile

by: D. C. Hendrix, Watermaster Dist. #15