


SECTION

TOWNSHIP 35 S, RANGE 8 W., W. M.

North

West

East

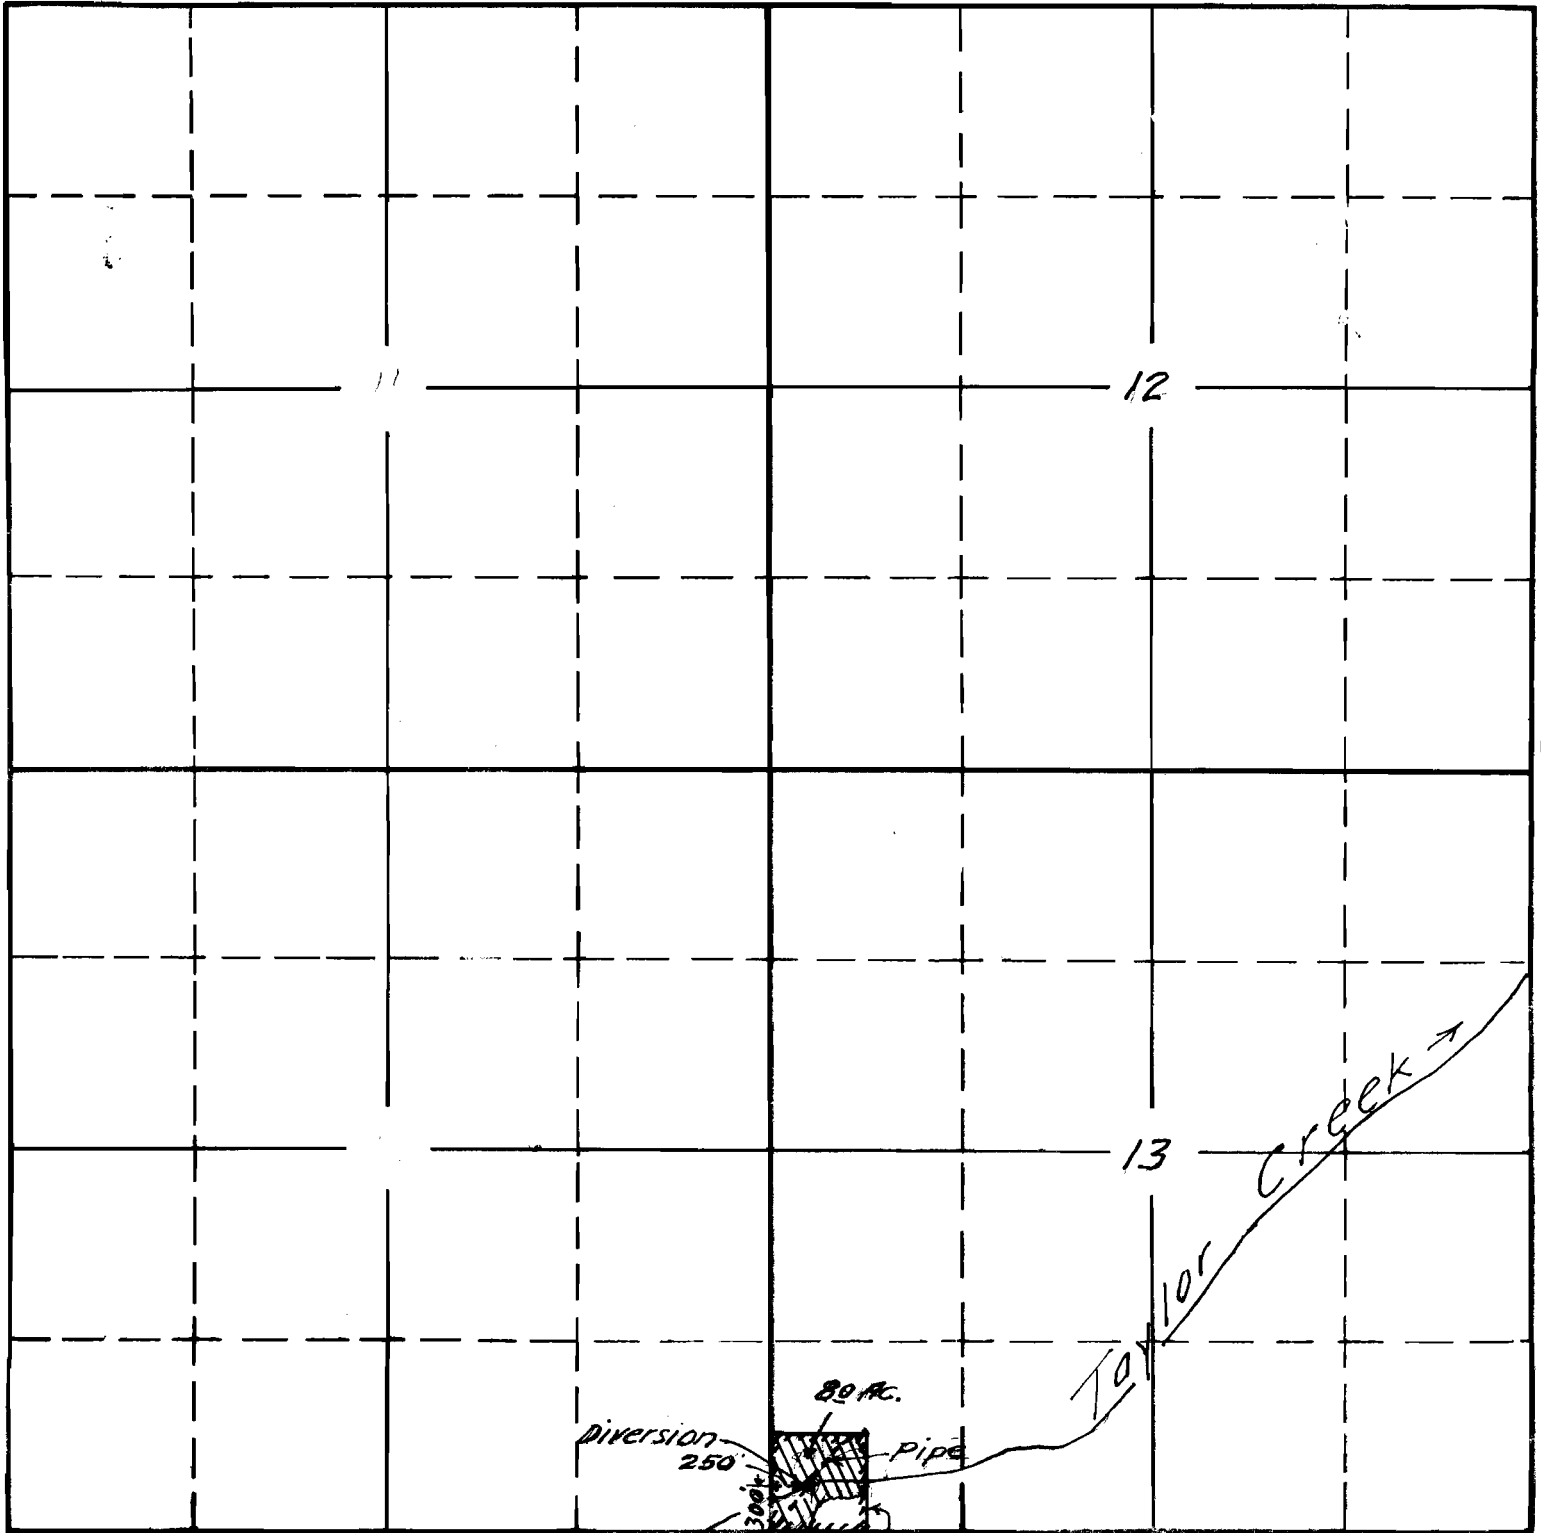

PAUL S. ENGLISH
Mar. 1946

APPLICATION No. 21514
PERMIT No. 16871