


T. 27S. R. 13W. WM.

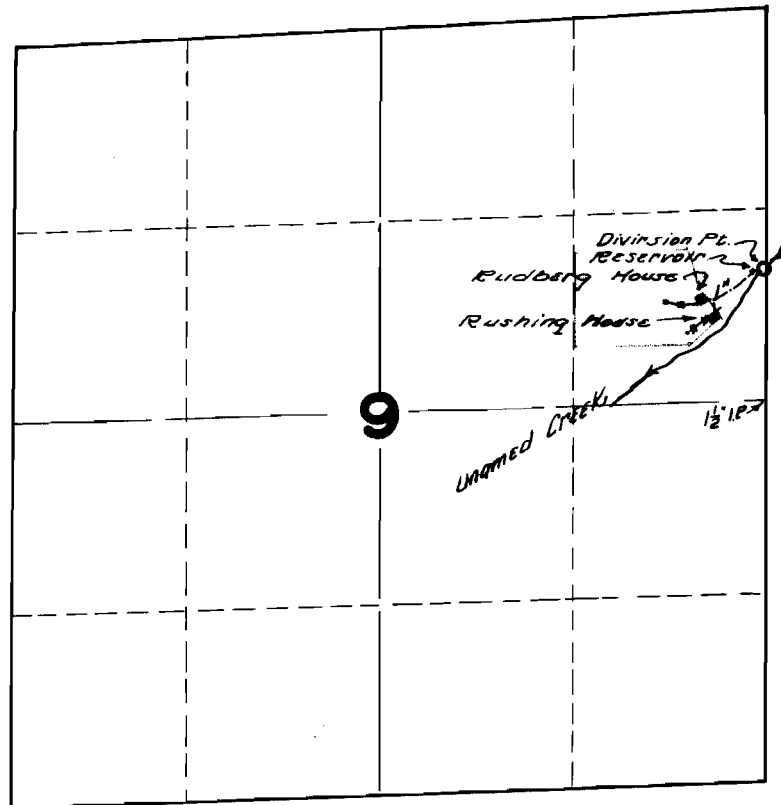

FINAL PROOF SURVEY
UNDER

Application No. 21501.... Permit No. 16928...
IN NAME OF

ADOLPH RUDBERG, THEODORE RUSHING AND MARY RUSHING

Surveyed SEP. 17 1949., by H.L. COFFMAN.