


T.3N. R.2W.W. M.

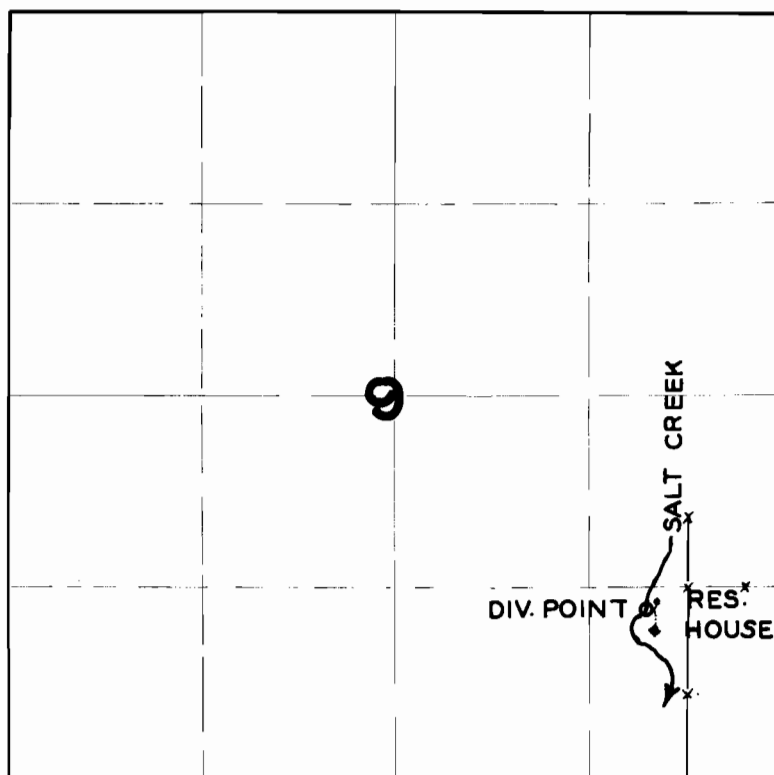

FINAL PROOF SURVEY

UNDER

Application No. 23077. Permit No. 18295.

IN NAME OF

HAROLD L. SHAFER

Surveyed AUG. 10. 1950, by H. L. COFFMAN