


T.30S.R.4W.W.M.

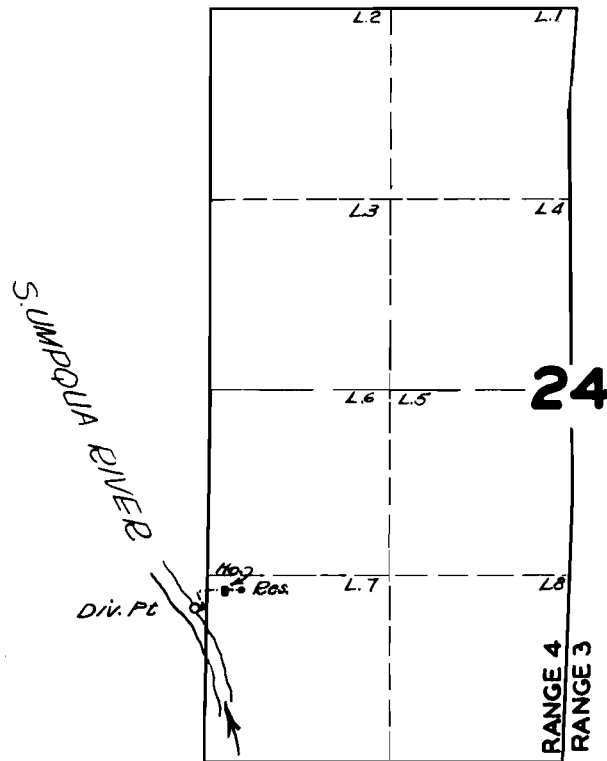

FINAL PROOF SURVEY

UNDER

Application No. **22740** Permit No. **17931**

IN NAME OF

J. A. UNGER

Surveyed **MAY 22 1950**, by **H.L. COFFMAN**.