




, Range 23 E.W.M. .

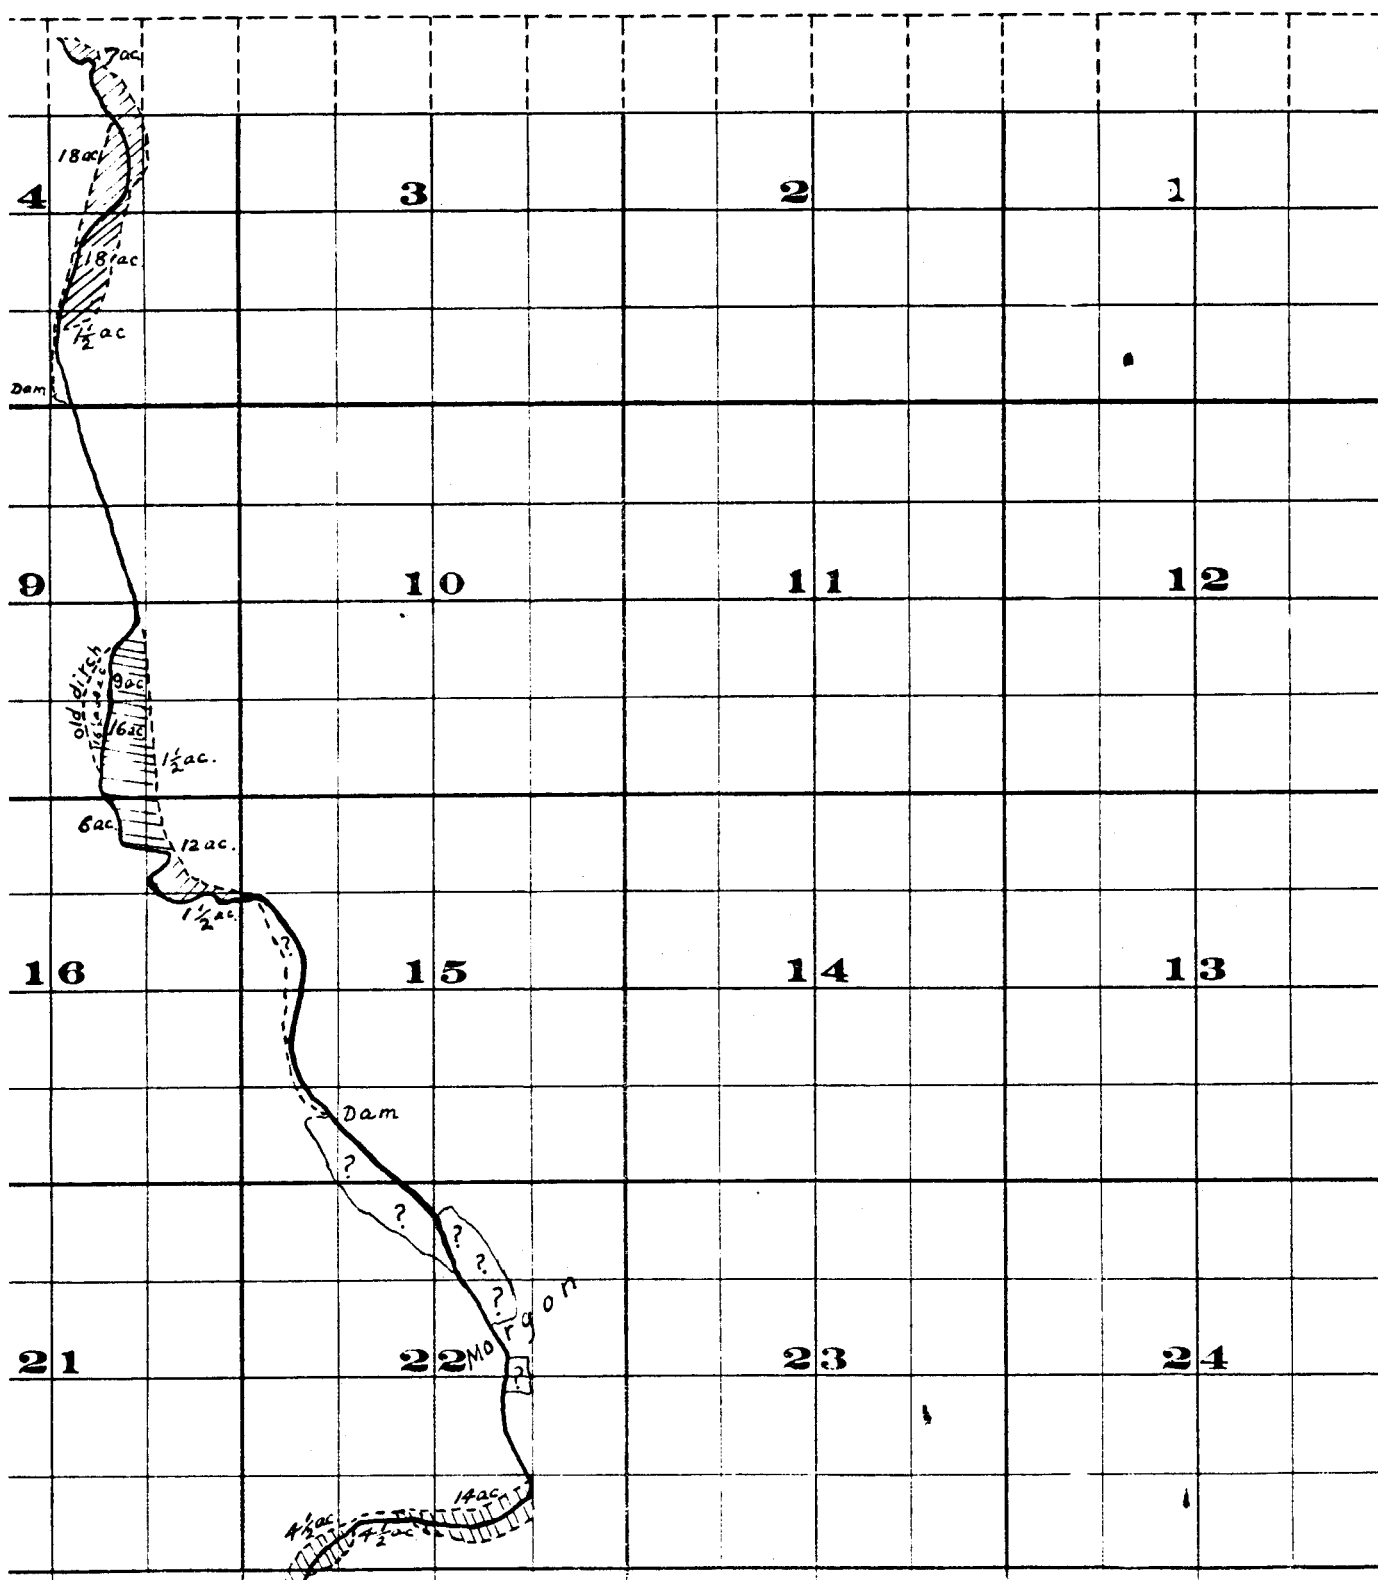

Township 1 N.

, I

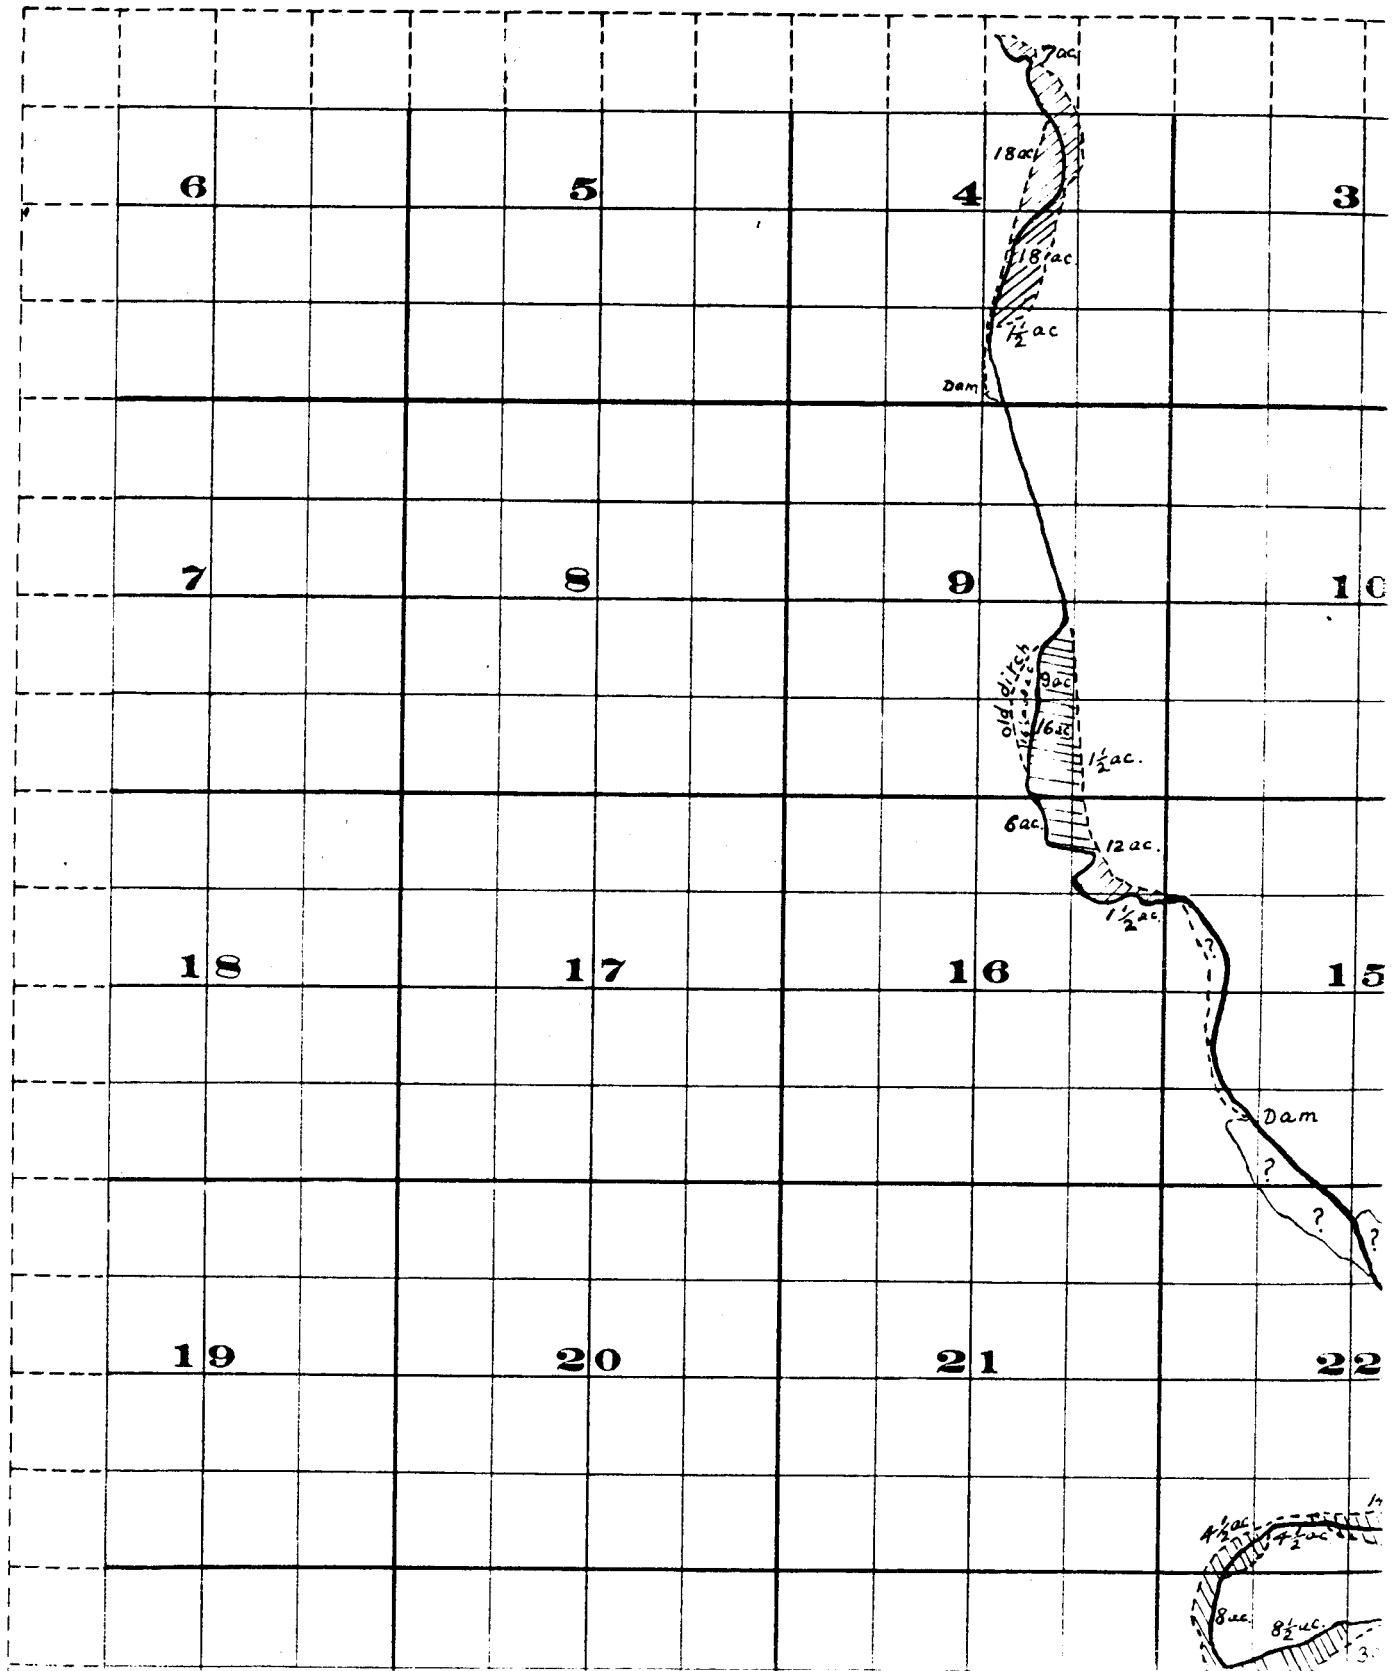


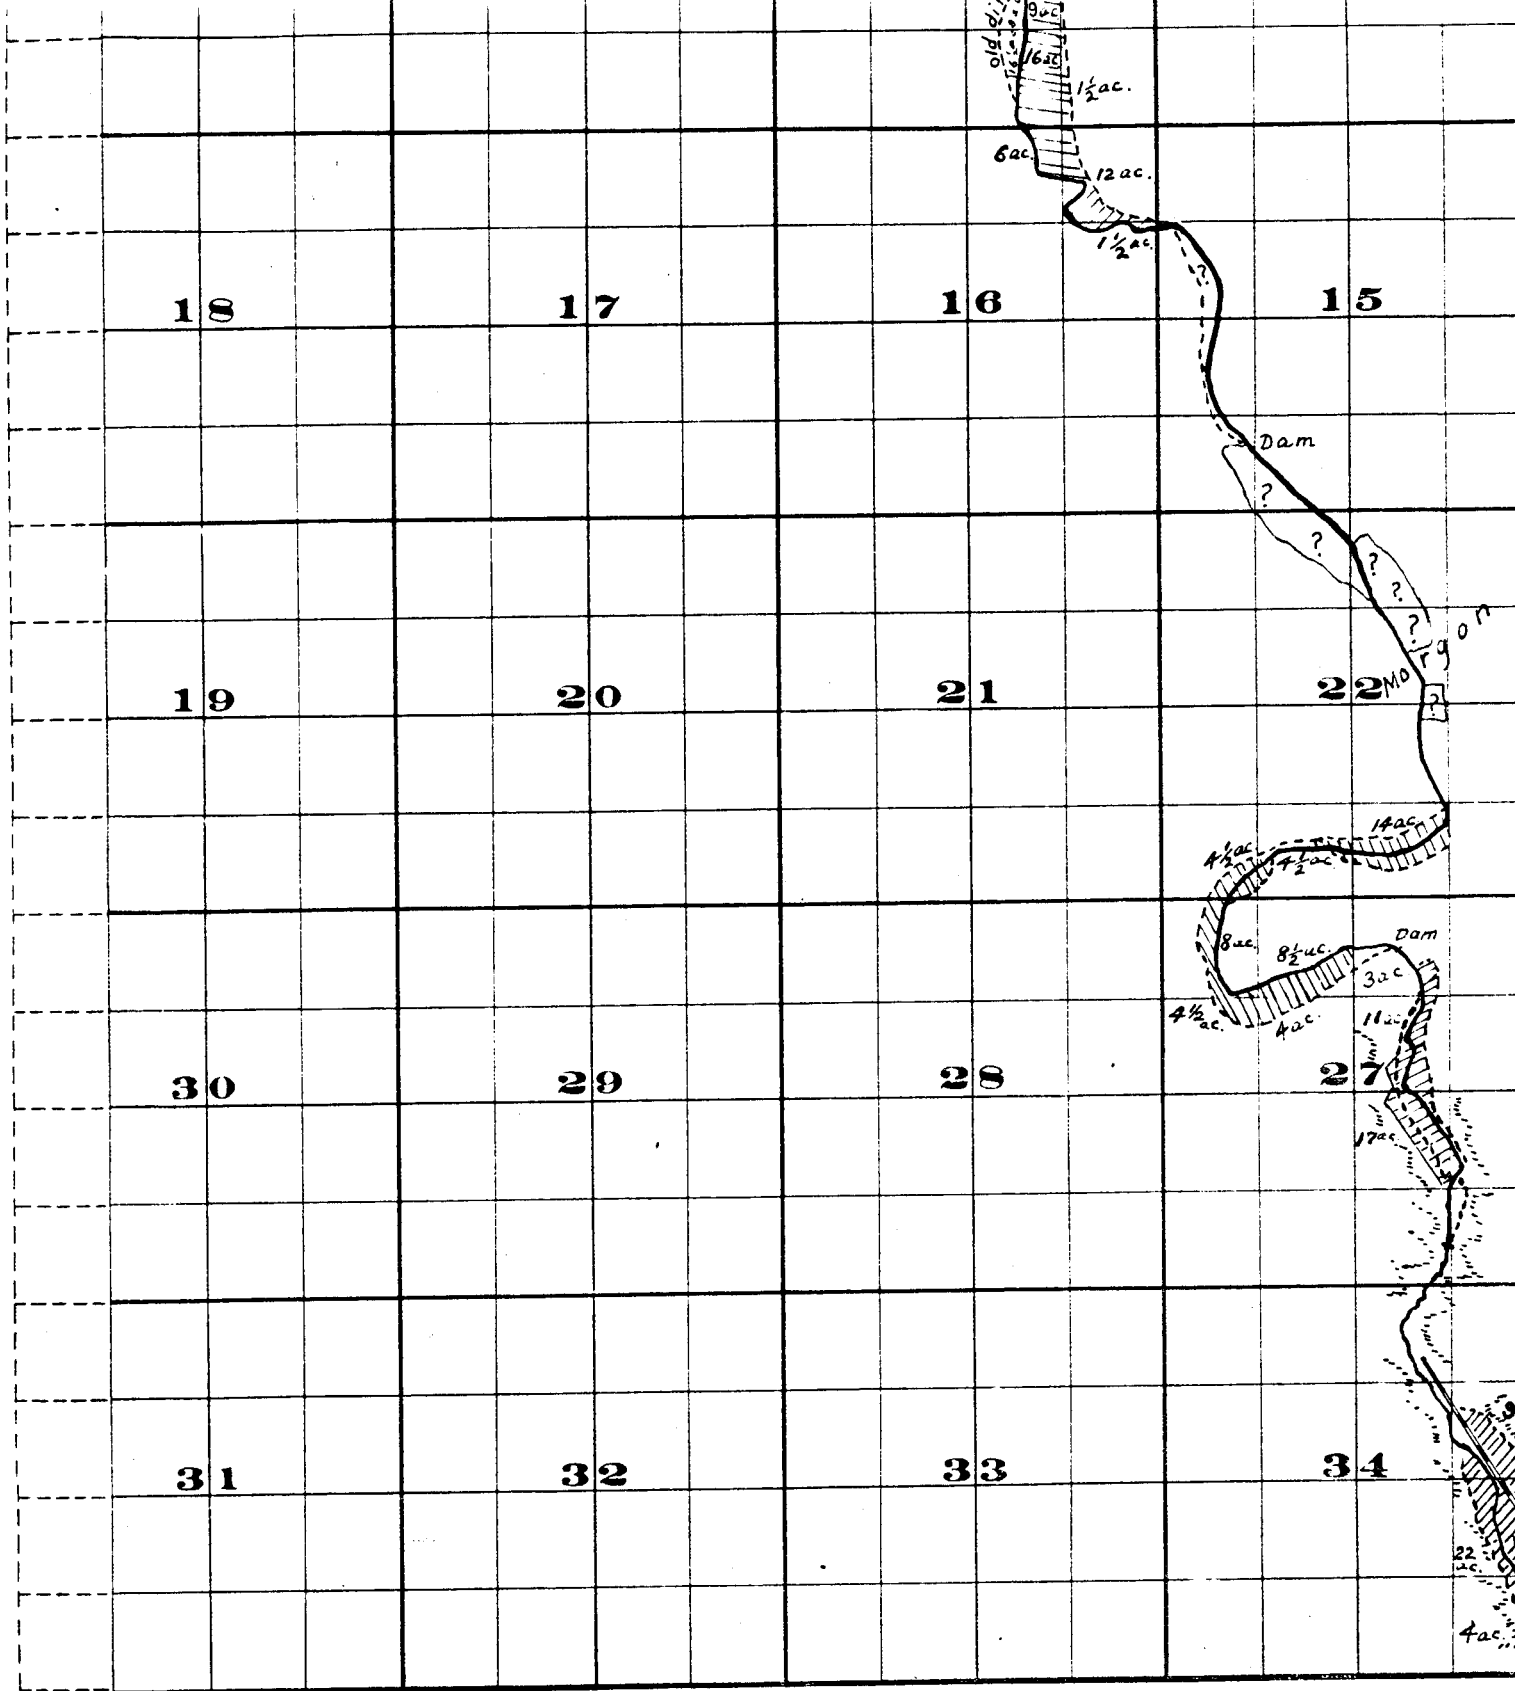

Surveyed by H. H. Donnelly July 1909, S. 27 North
 Surveyed by R. D. Cooper July 1909, S. 27 South

John H. Lewis - State Engineer

Examined July 14, 1909.

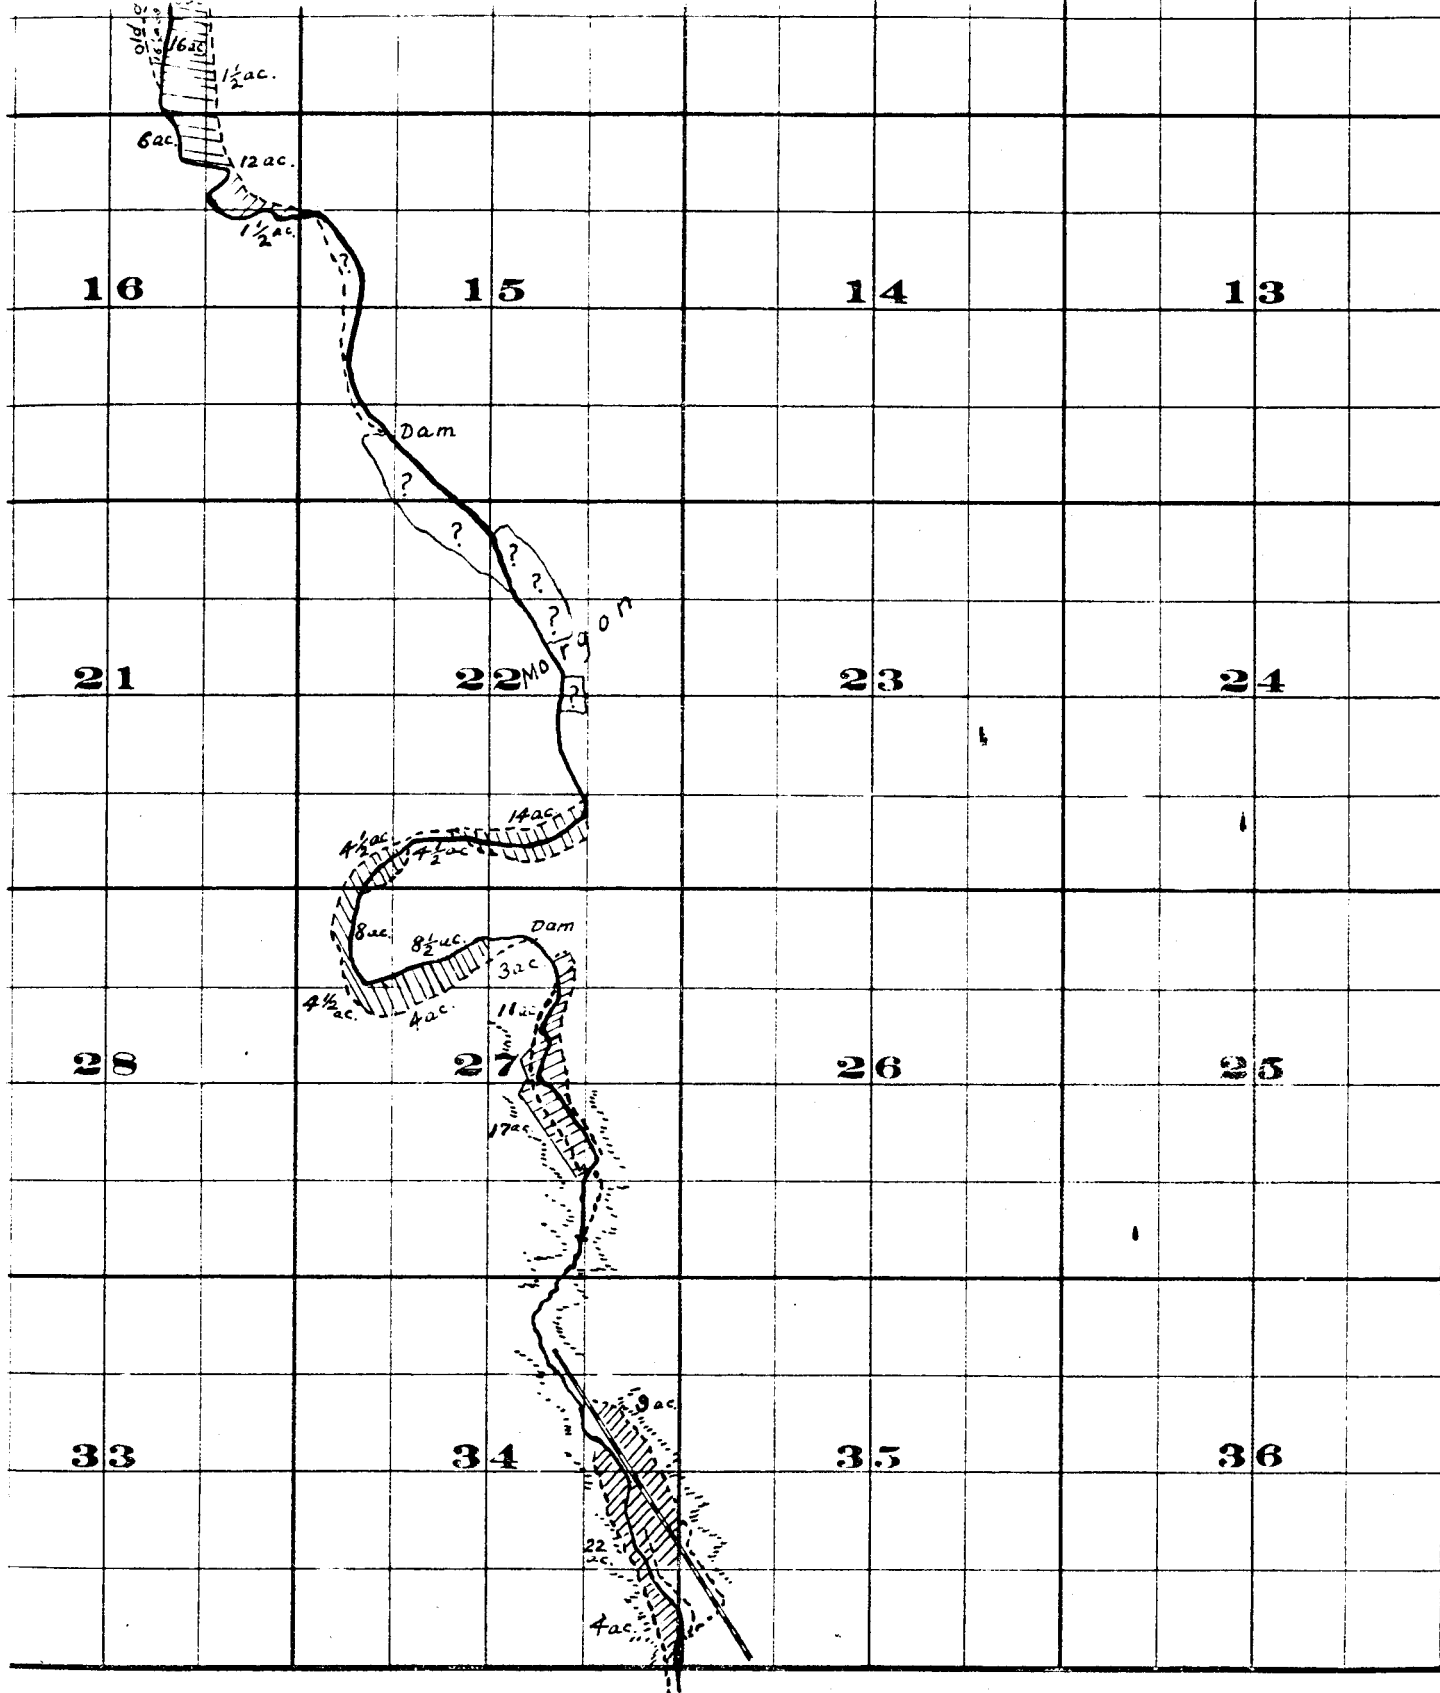

FROM OFFICE OF THE STATE ENGINEER, SALEM, OREGON

Willow Creek Adjudication

S. 27 North

S. 27 South

ineer

909.