


T.17S.R.3W.W.M.

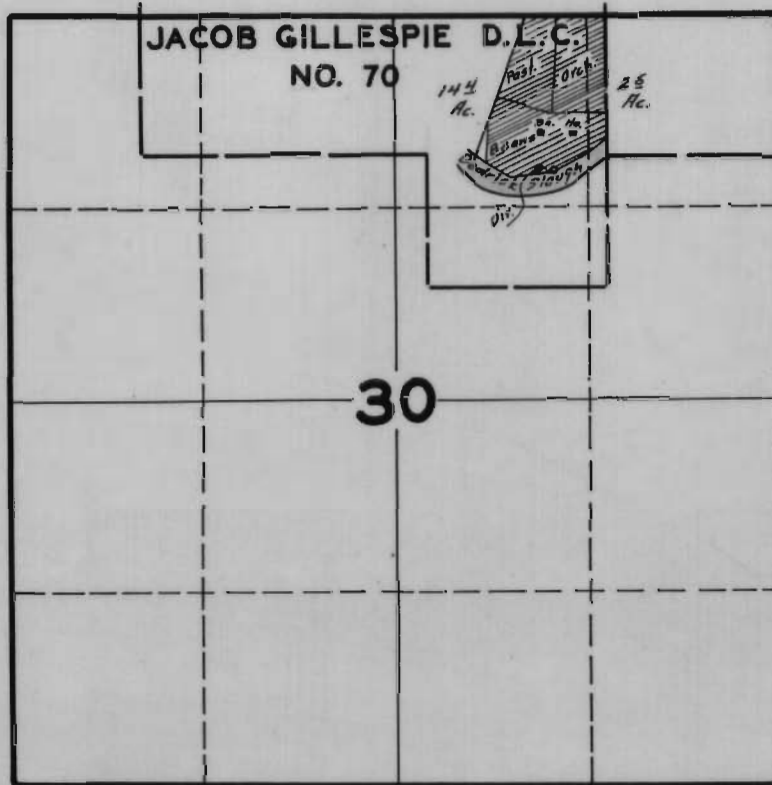

FINAL PROOF SURVEY
UNDER

Application No. 20806 Permit No. 16282

IN NAME OF

J. F. HEIDENREICH

Surveyed AUG. 1, 1946, by *J. F. Heidenreich*