


T.4|S.R.13W.W.M.

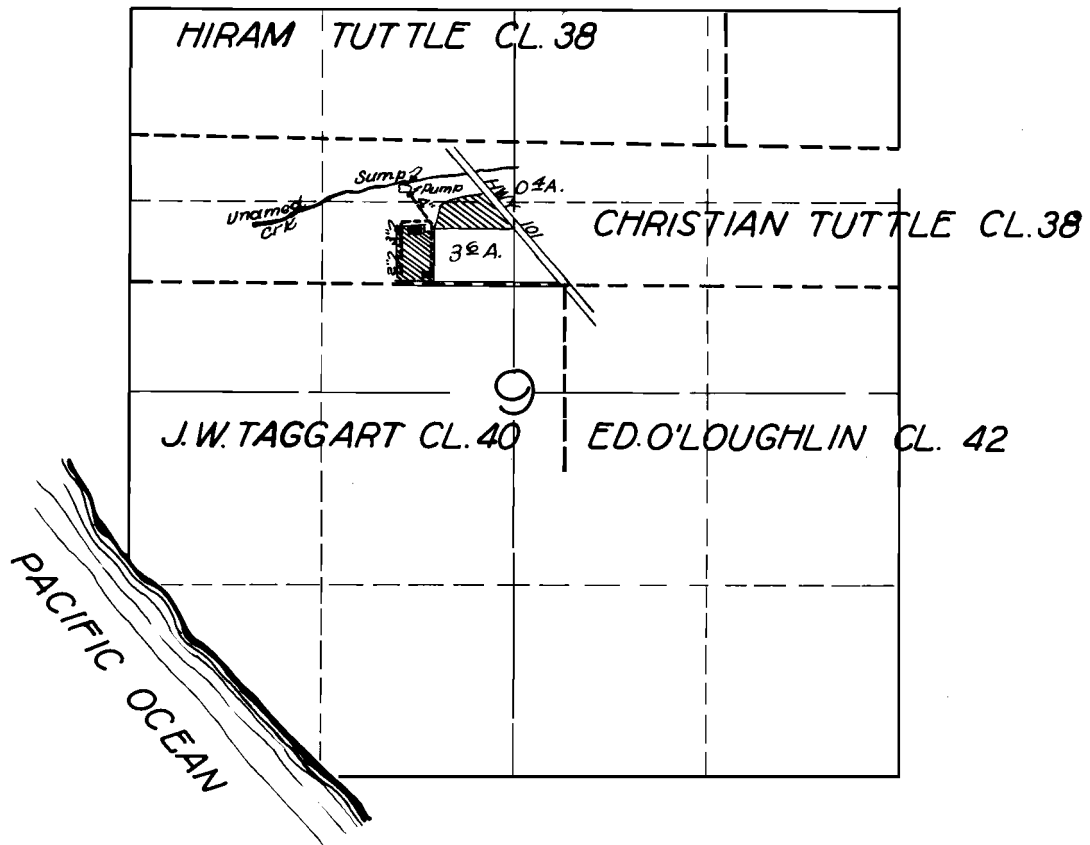

FINAL PROOF SURVEY

UNDER

Application No. *20458* Permit No. *16216*....

IN NAME OF

FLORENCE ANDERSON & ARCHIE E. ANDERSON

Surveyed *AUG. 3*... 1949., by *H.L. COFFMAN*..