


**T.22S. R.3W.W.M.**

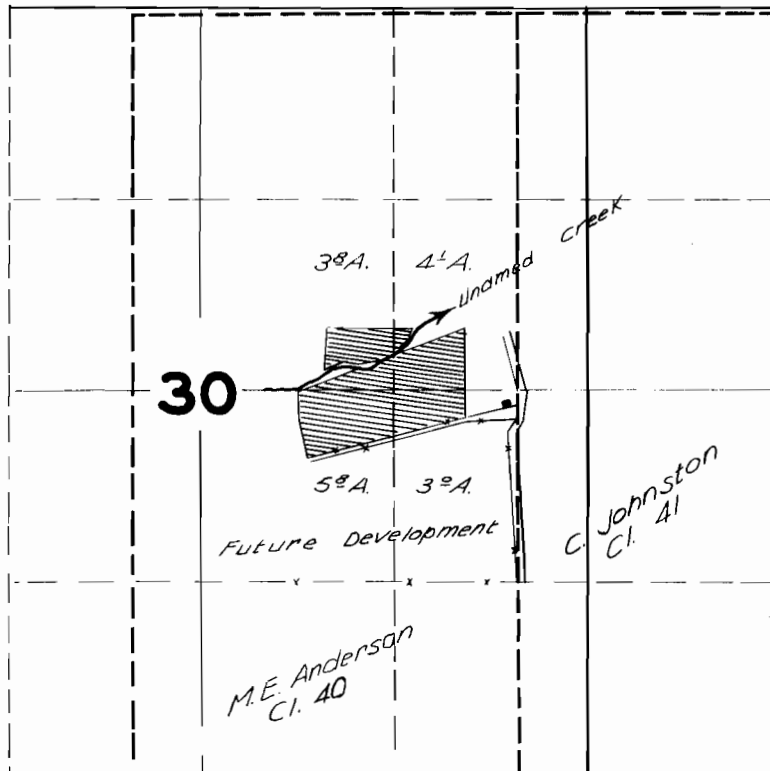

**FINAL PROOF SURVEY**  
UNDER

Application No. **20336** Permit No. **15864**  
IN NAME OF

**P.M. & MABEL A. CAMPBELL**

Surveyed JUNE 22 1949., by **H.L. COFFMAN**