


# T.7S.R.3W.W.M.

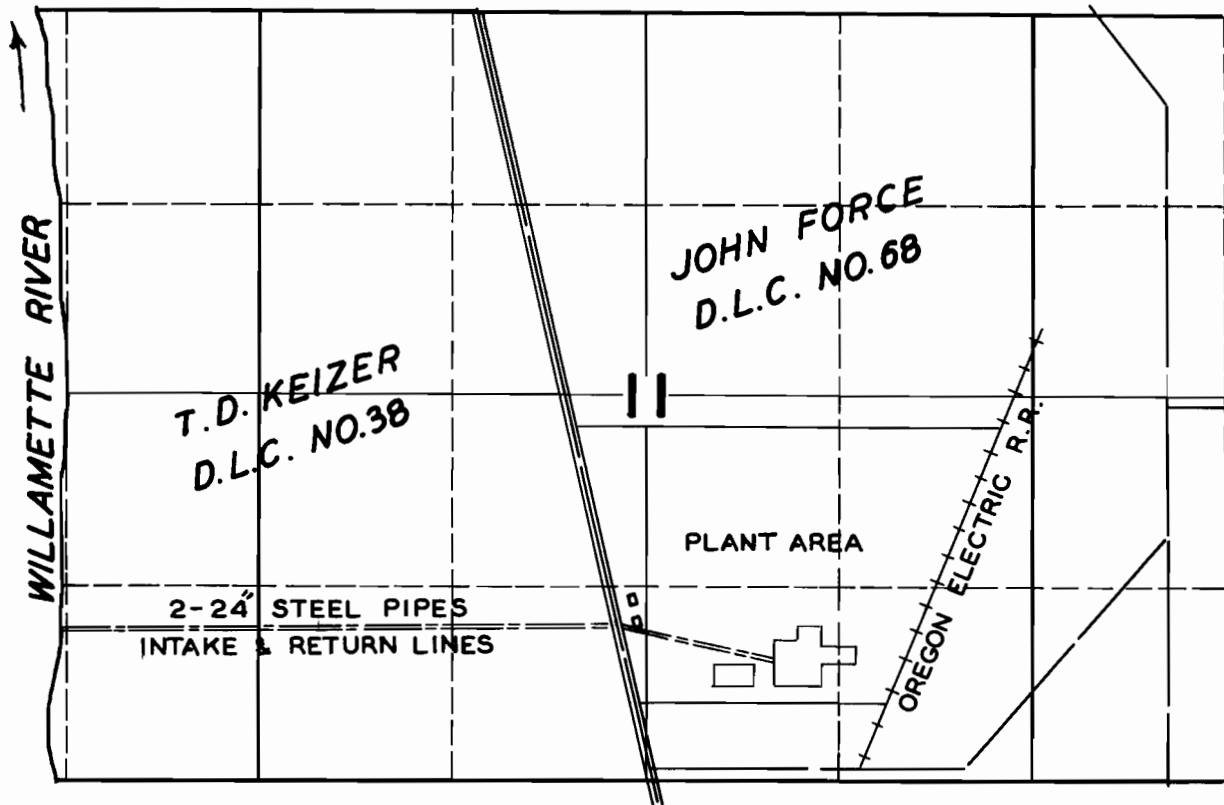

## FINAL PROOF SURVEY

UNDER

Application No. **20283** Permit No. **15823**

IN NAME OF

**COLUMBIA METALS CORPORATION**

Surveyed **APR. 8** 1948, by **JAS. E. BUNNELL**