


T. 8 S. R. 6 W. W. M.

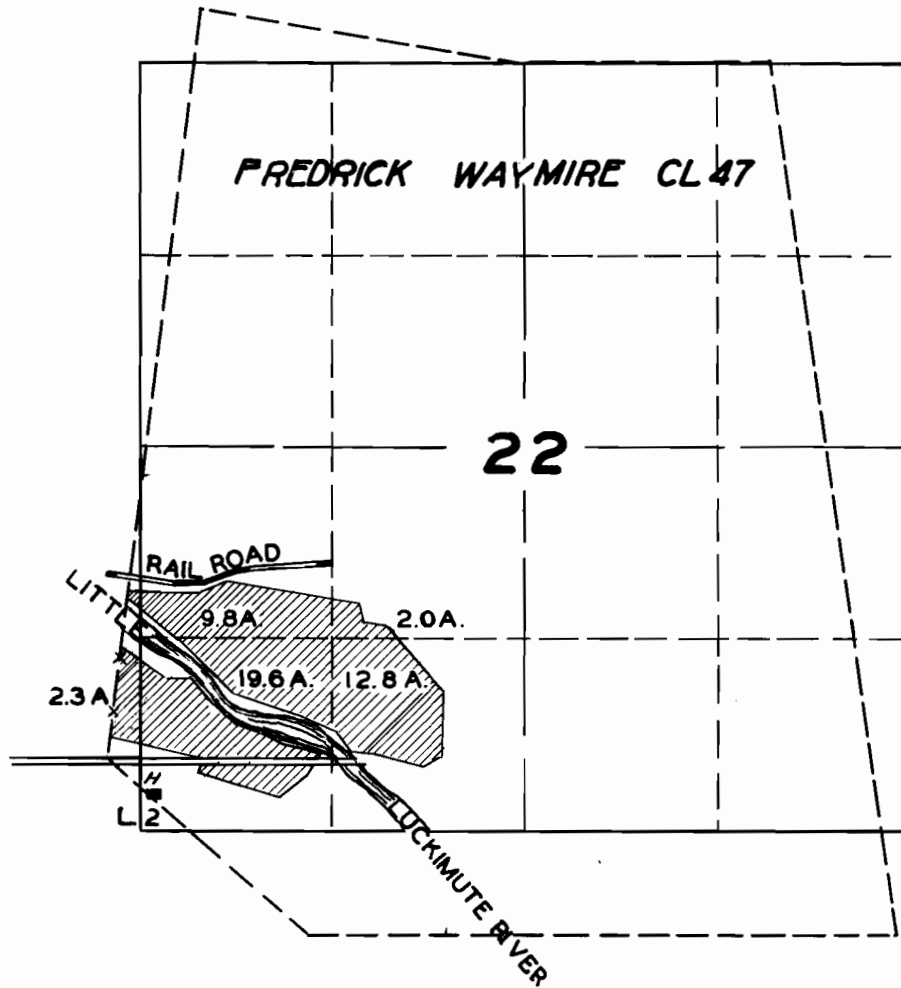

FINAL PROOF SURVEY
UNDER

Application No. 19792 Permit No. 15470
IN NAME OF

WILFRED KENNETH CUMMINS

Surveyed APR. 12. 1950., by H.L. COFFMAN