T. 1 N. R. 4 W. W. M.

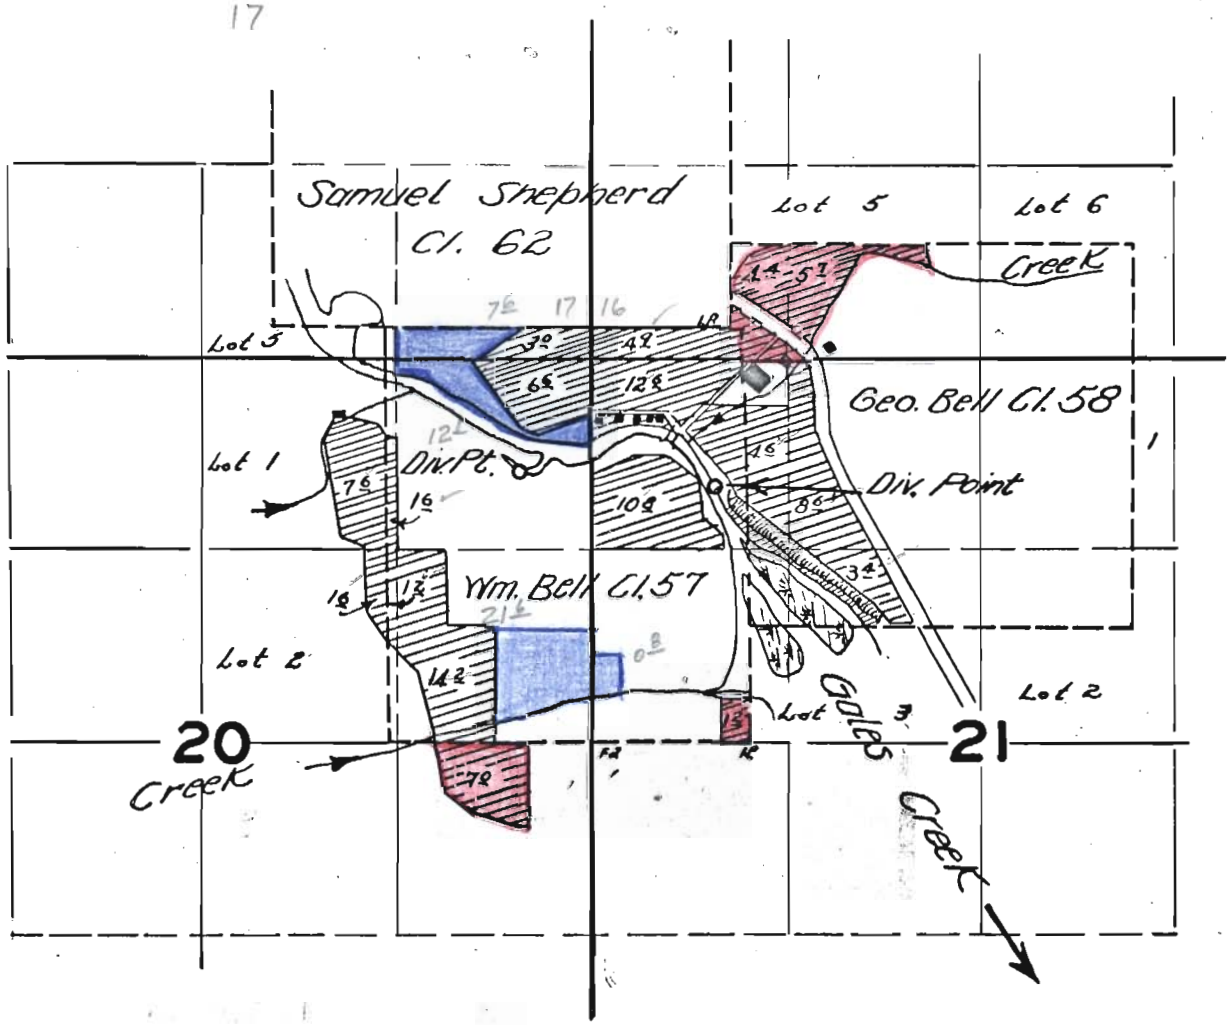

FINAL PROOF SURVEY

UNDER

Application No. 15909 Permit No. 11746

IN NAME OF

JEAN K. & ROBERT H. WARRENS

Surveyed APRIL 2 1951, by H.L. COFFMAN

1951 A