


# T.25S.R.13W.W.M.

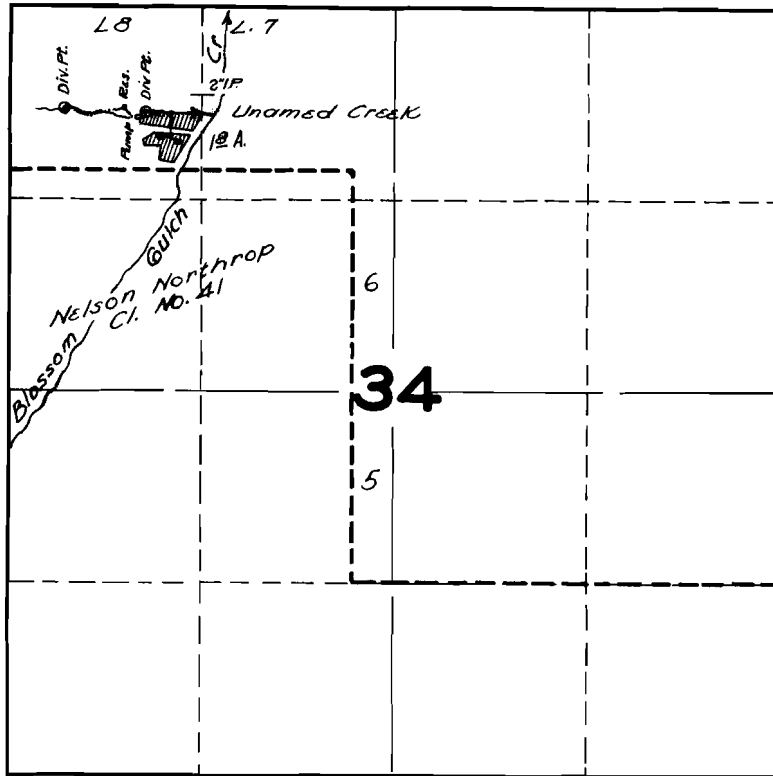

## FINAL PROOF SURVEY

UNDER

Application No. 20382 Permit No. 15895.

IN NAME OF

ARTHUR W. & HELEN G. SMITH  
JAMES & VALETA WILSON

Surveyed AUG. 25 1949, by H. L. COFFMAN