


T. 26S.R.13W.W.M.

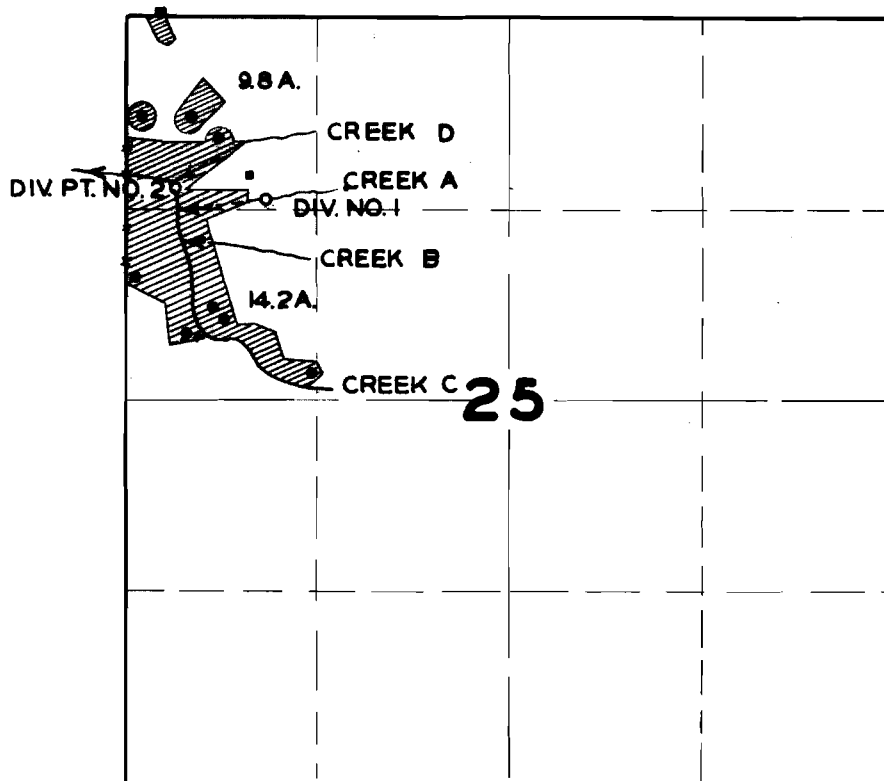

FINAL PROOF SURVEY UNDER

Application No. 21289 Permit No. 16693
IN NAME OF

COOS COUNTRY CLUB

Surveyed SEPT. 10 1949, by H.L. COFFMAN