


16781

T.1N.13E.W.M.

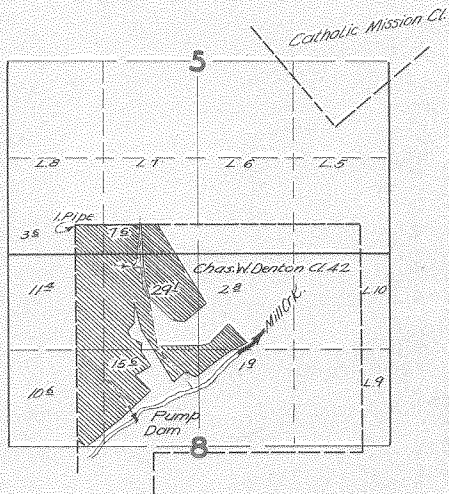

FINAL PROOF SURVEY

UNDER

Application No. 21419 Permit No. 16781

IN NAME OF

NIELSEN BROTHERS

Surveyed SEPT. 11 1950, by H.L. COFFMAN