


T.7N.R.2W.W.M.

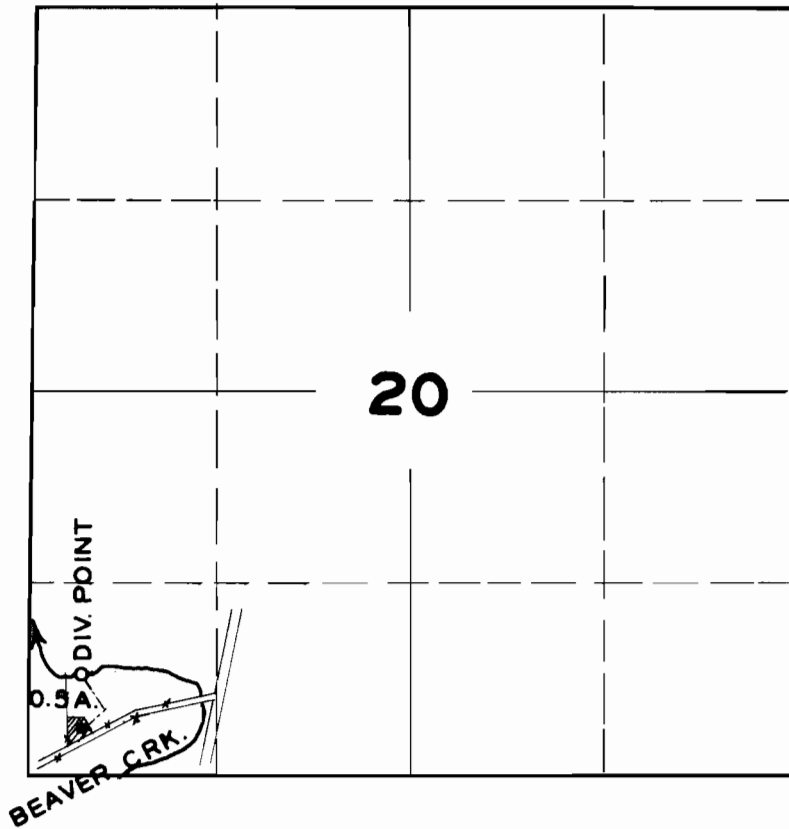

FINAL PROOF SURVEY

UNDER

Application No. 21570... Permit No. 16949..

IN NAME OF

..... WALTER I. TRACY

Surveyed AUG. 1. 1950., by H.L. COFFMAN