


T. 4S. R. 2W. W.M.

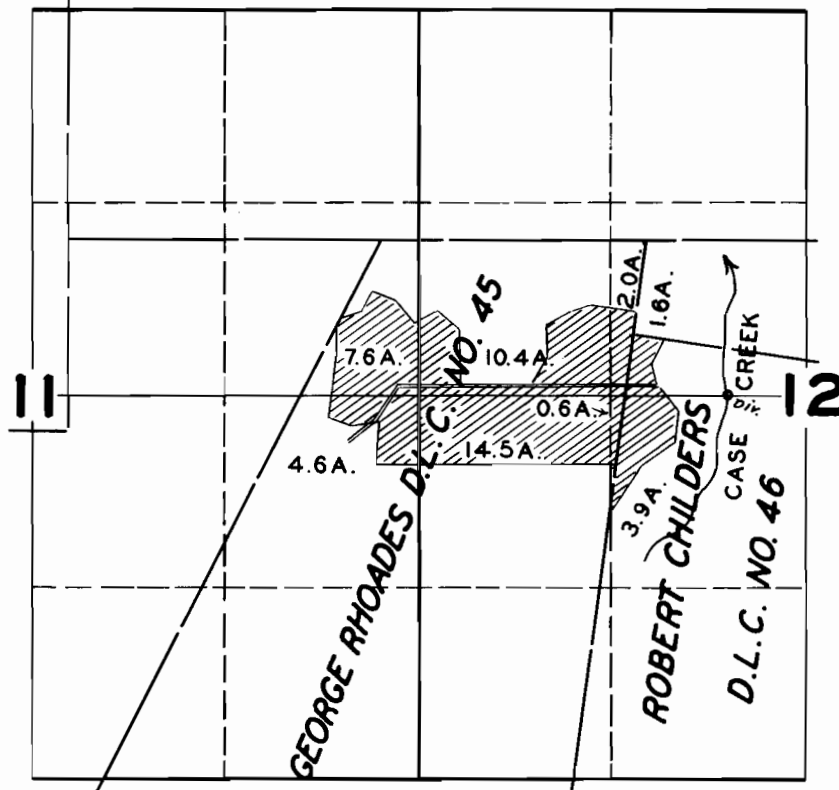

FINAL PROOF SURVEY
UNDER

Application No. 20206 ... Permit No. 15757
IN NAME OF

MRS. ARVID A. THUMBERG

Surveyed MAY 3, 1949, by JAS. E. BUNNELL