


T. 26 S.R.3 W.W.M.

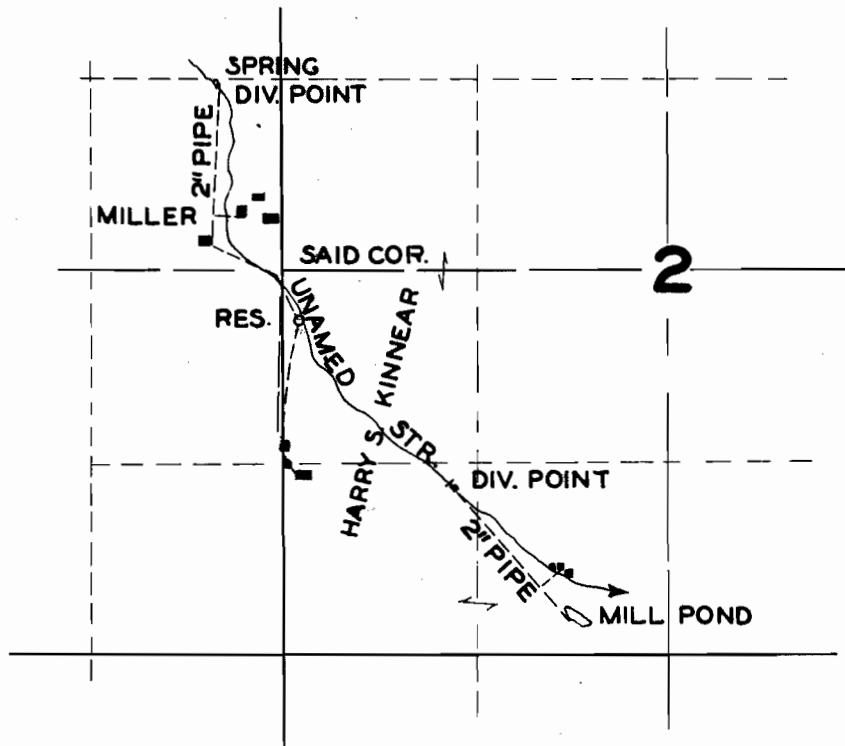

FINAL PROOF SURVEY UNDER

Application No. 18853.. Permit No. 14487.
IN NAME OF

HARRY S. KINNEAR

Surveyed 7/12 1949, by H.L. COFFMAN