


U-245  
19749

# T.38S.R.11 1/2 E.W.M.

Buck Cr. & your a Valley wells

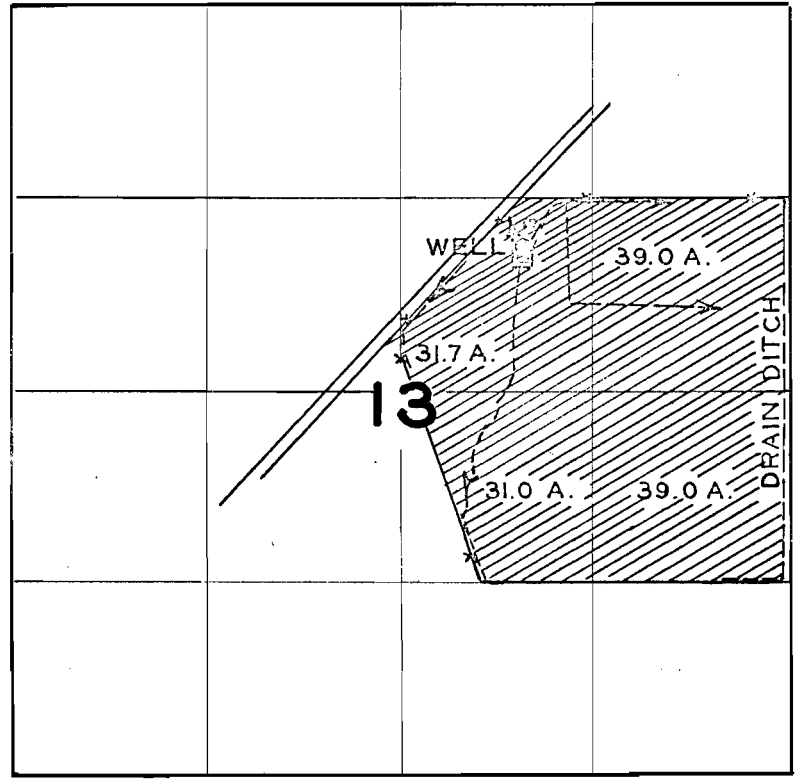

## FINAL PROOF SURVEY UNDER

Application No. U-273... Permit No. U-245  
IN NAME OF

RAYMOND MARTIN ROBERTSON

Surveyed MAY 17, 1951, by J.H.L. COFFMAN